


# T. 7S., R. 2W., W.M.

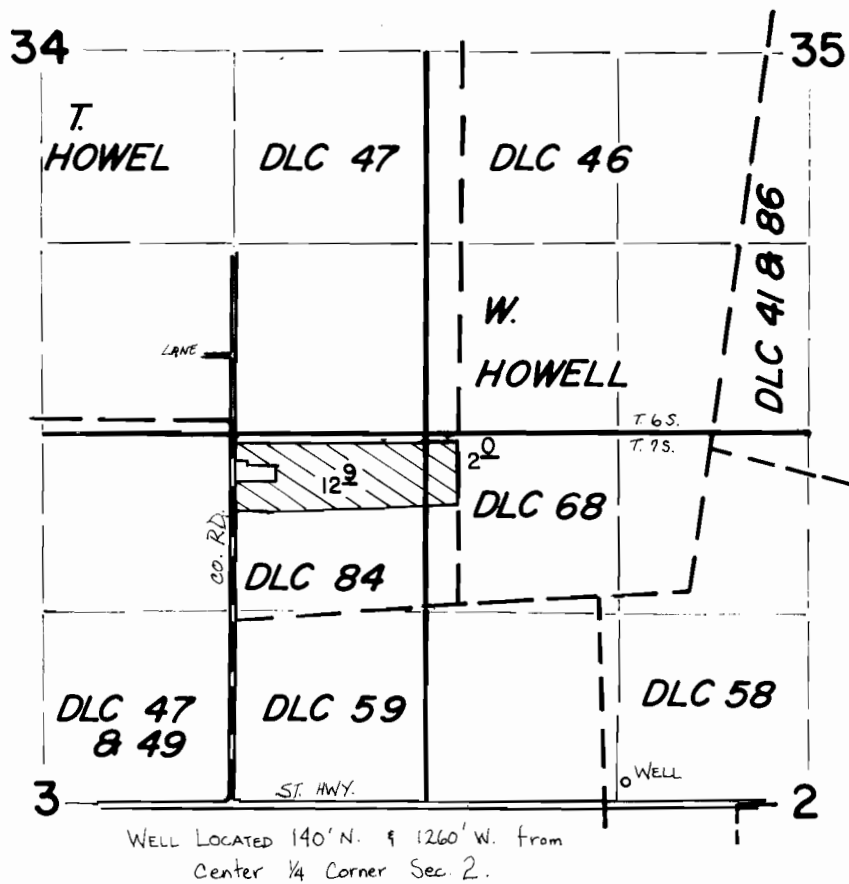

## FINAL PROOF SURVEY UNDER

Application No. G 10418 Permit No. G. 9600...  
IN NAME OF

**EDWARD A. HARI**

Surveyed NOV. 16, 1983, by M. CAHILL