


6-9601
65947

T. 39 S., R. 10 E., W. M.

SECTIONS 5 & 6

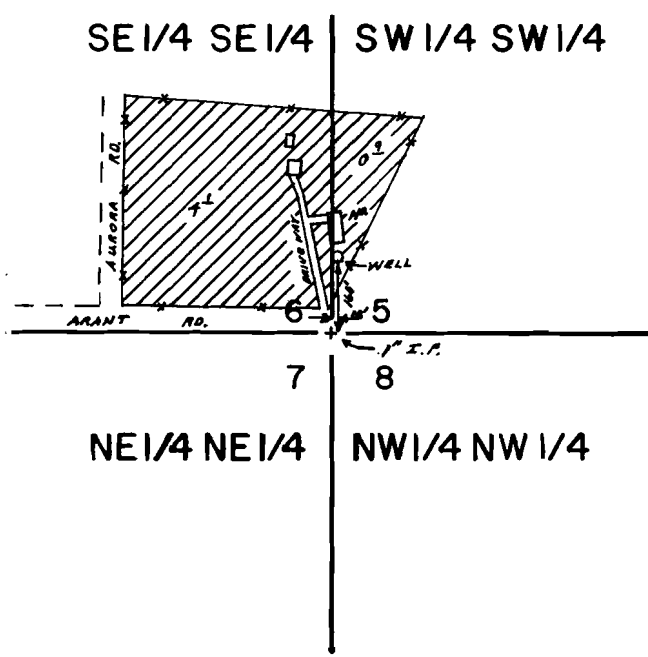

SCALE: 1" = 400'

FINAL PROOF SURVEY
UNDER

Application No. G10420 Permit No. G-9601
IN NAME OF

MICHAEL L. BELL

Surveyed AUG. 18... 1987., by M. MATTICK.....