


T.21S., R.10E., W.M.

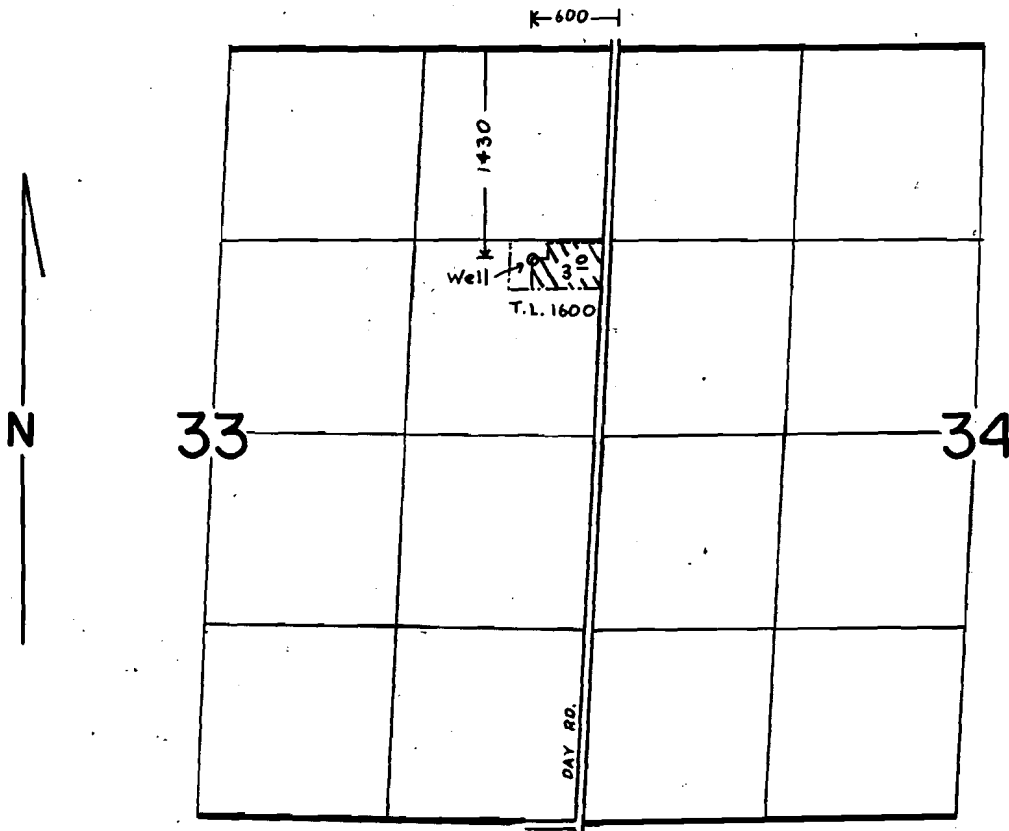

SCALE: 1" = 1320'

FINAL PROOF SURVEY
UNDER

Application No. G-10428 Permit No. G-9606.....
IN NAME OF

ARMOND S. & CAROLYN M. PAULING

Surveyed MAY 27.... 1986., by L. OLSON & M. MATTICK

Cont. #65948

G-9606