


T.21S., R.10E., W.M.

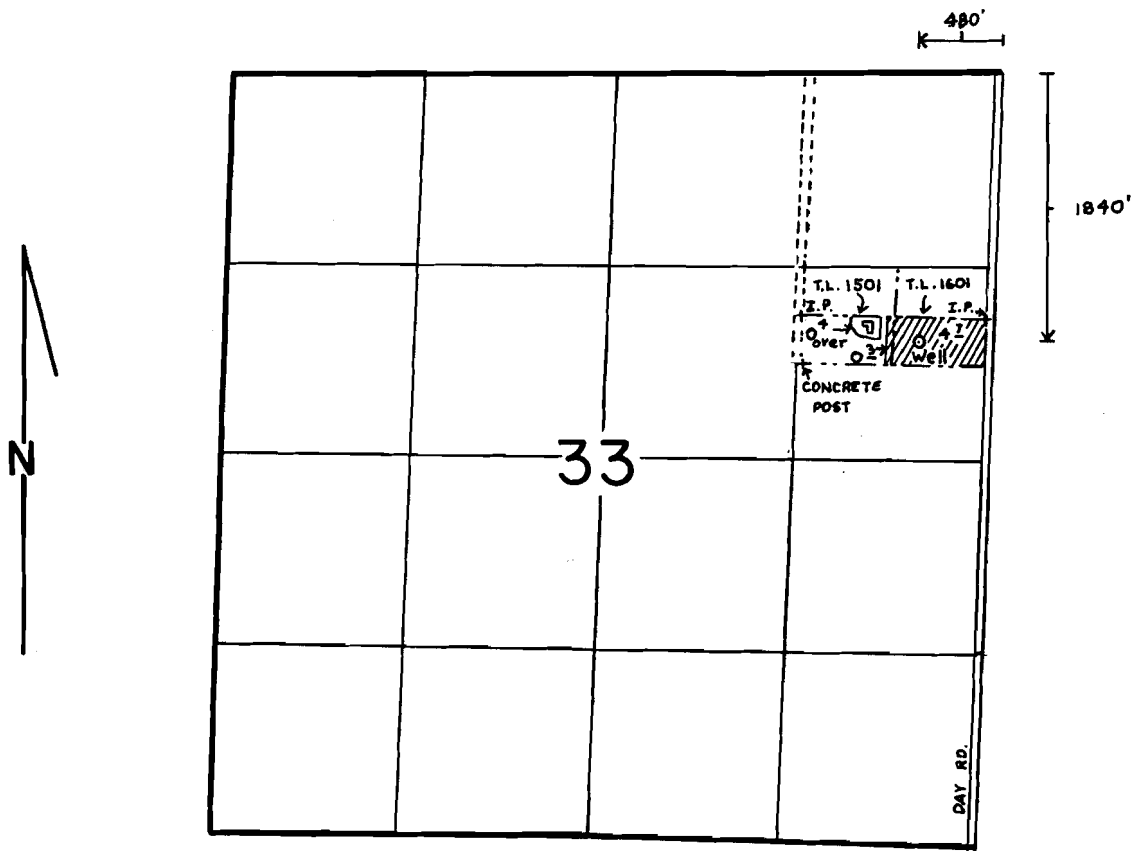

SCALE: 1" = 1320'

FINAL PROOF SURVEY
UNDER

Application No. G-10436, Permit No. G-9609

Cert. 65949

IN NAME OF

MANUEL S. CARDOZA

Surveyed MAY 27... 1986., by MICHAEL J. MATTICK

G-9609