


T. 36 S., R. 2 W., W. M.

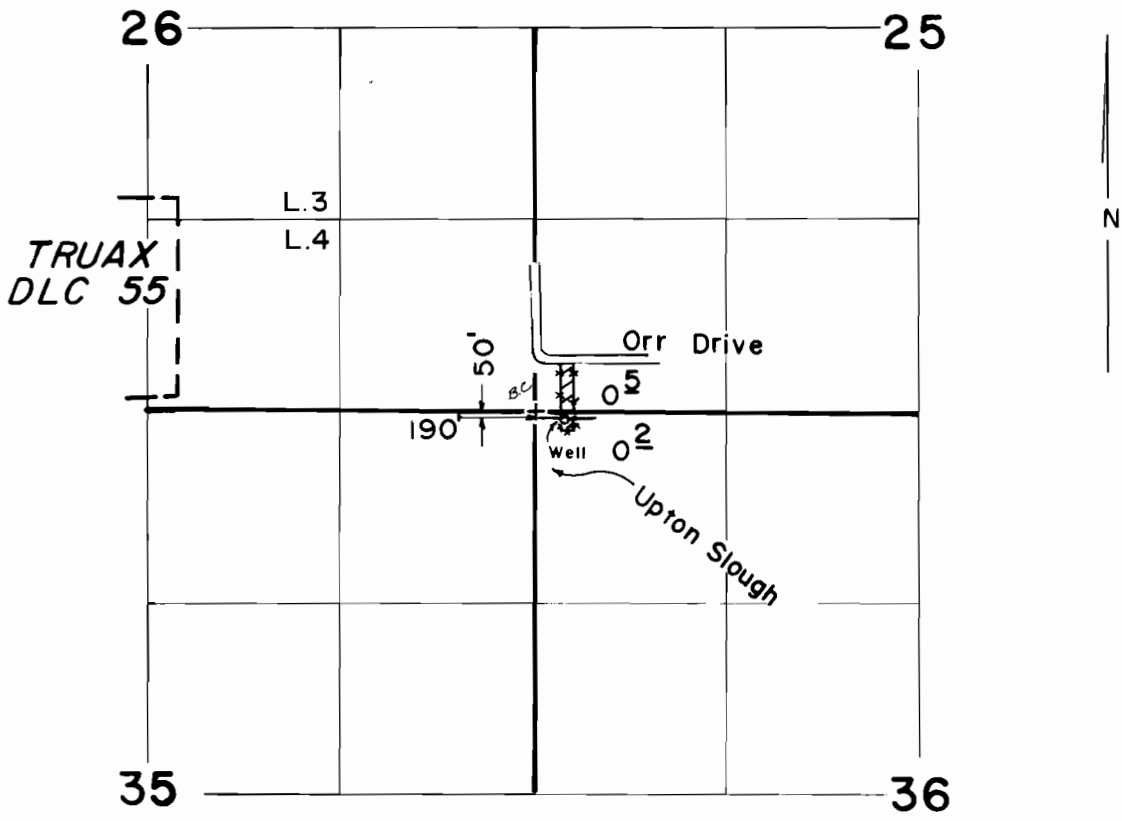

Scale: 1" = 1320'

FINAL PROOF SURVEY
UNDER

Application No. G-10451 Permit No. G-9638
IN NAME OF

.....ALEX. SHAYLOR.....

Surveyed MAY 27 1986, by B. S. JAMES.....