


# T.19S., R.47E., W.M.

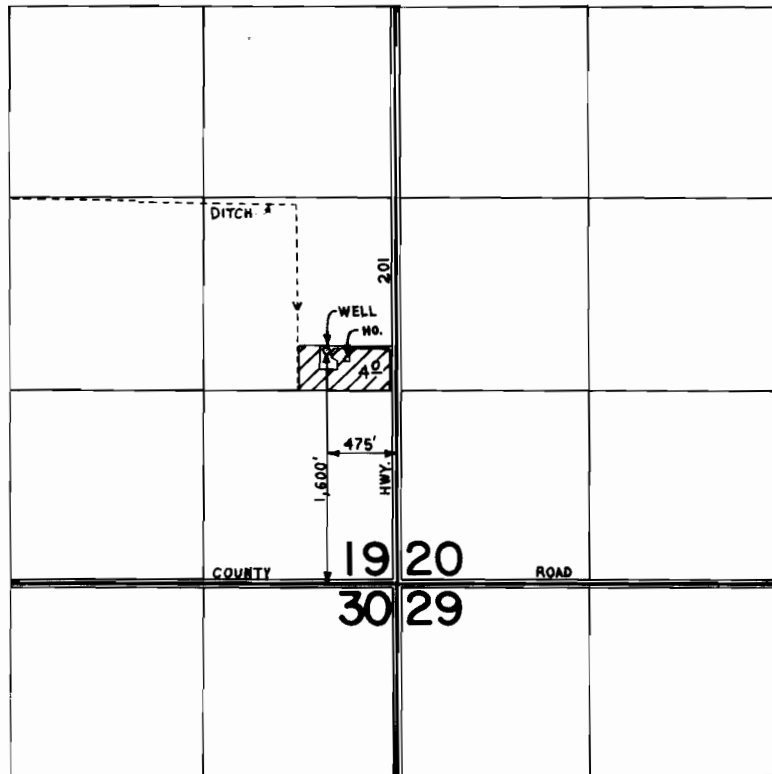

1" = 1,320'

## FINAL PROOF SURVEY UNDER

Application No. G-10474... Permit No. G-9645.....  
IN NAME OF

**CARL H. & LADENA M. SELLS**

Surveyed .FEB..26.. 1986.. by L. TOLL.....