


Application No. G-10521
Permit No. G 9677

T.5S. R.1&2W., W.M.

RECEIVED

AUG 18 1981
WATER RESOURCES DEPT.
SALEM, OREGON

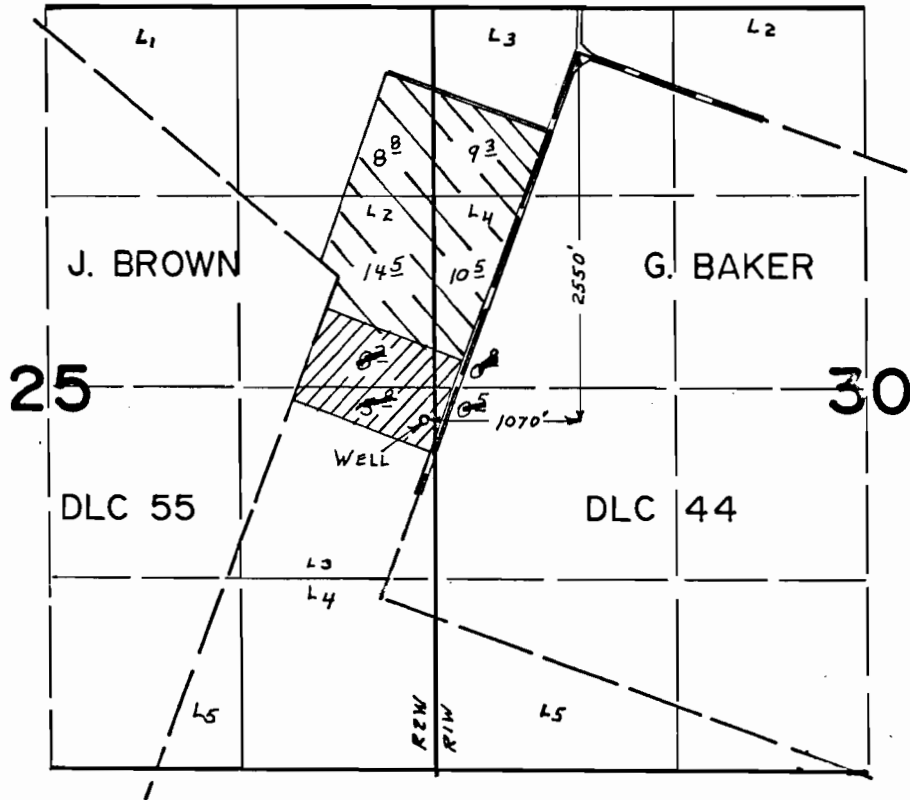

FINAL PROOF SURVEY
UNDER

~~Application No. G-5546 Permit No. G-5425~~
IN NAME OF

~~LYMAN EDER~~

~~Surveyed SEP 29 1978 by S. R. APPLIGATE~~