


T.6 S., R.2 W., W.M.

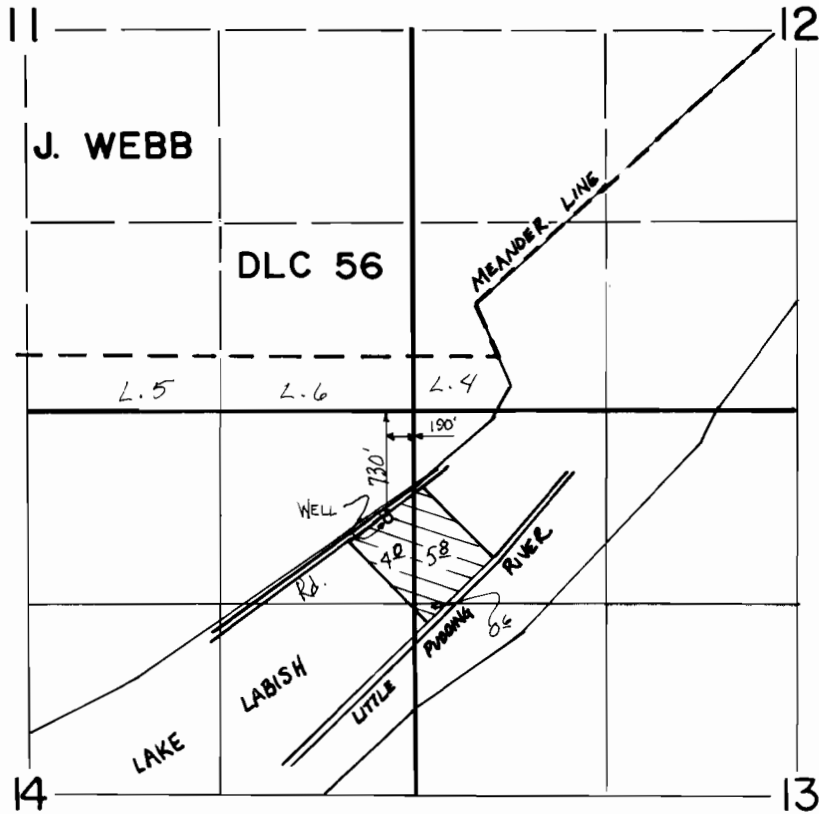

FINAL PROOF SURVEY UNDER

Application No. G.10523 Permit No. G. 9678....
IN NAME OF

NORMAN CRAIG KLAMPE

Surveyed OCT. 24., 1983., by M. CAHILL.....