


T. 5 S., R. 1 W., W. M.

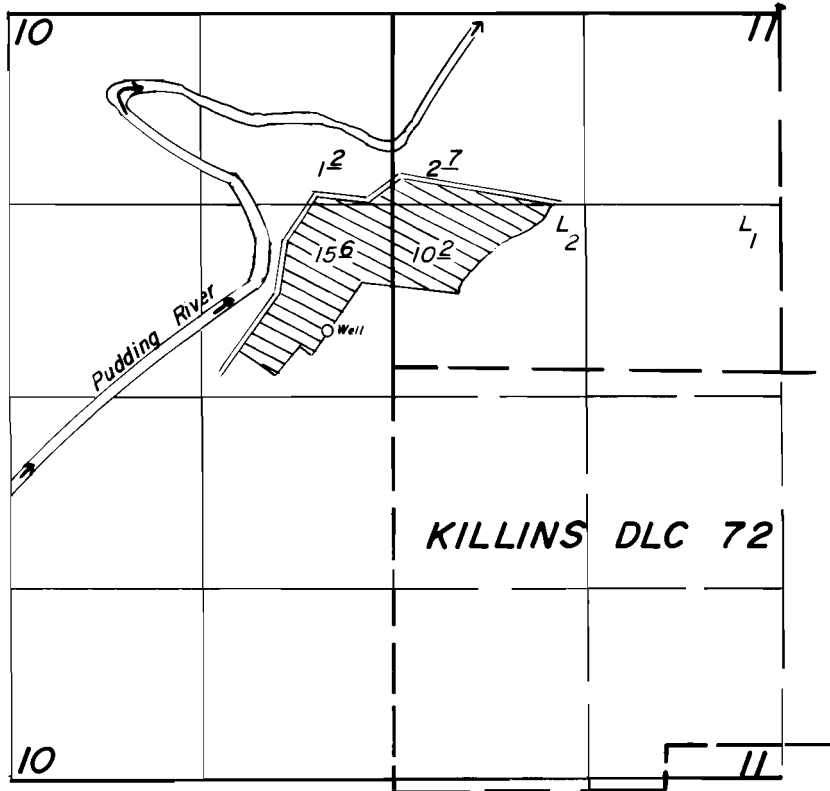

Well Loc.: 450' N. & 440' W. from W. 1/4 Cor. Sec. 11.

1" = 1320'

FINAL PROOF SURVEY
UNDER

Application No. ~~G-10538~~ Permit No. ~~G-9693~~.....
IN NAME OF

SAVIN KAMIS.....

Surveyed April 20, 1984, by T. Warren.....