


T.15 S., R.12 E., W. M.

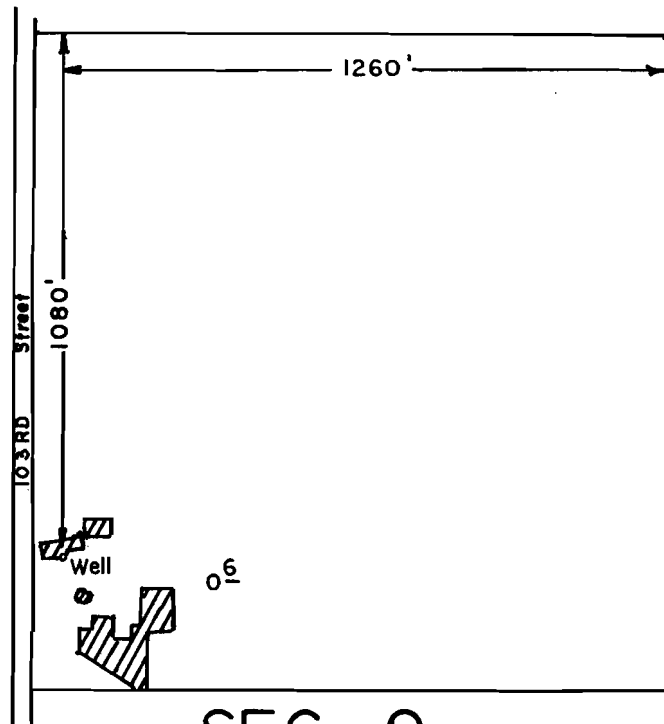

SEC. 9
NE 1/4 SE 1/4

SCALE: 1" = 400'

FINAL PROOF SURVEY
UNDER

Application No. G-10562. Permit No. G-9452...
IN NAME OF

Cert. #65955

.....**NOLAN P. WILLIAMS**.....

Surveyed NOV. 13. 1987., by M.J. MATTICK....

G-9452