


T. 35 S., R. 2 W., W. M.

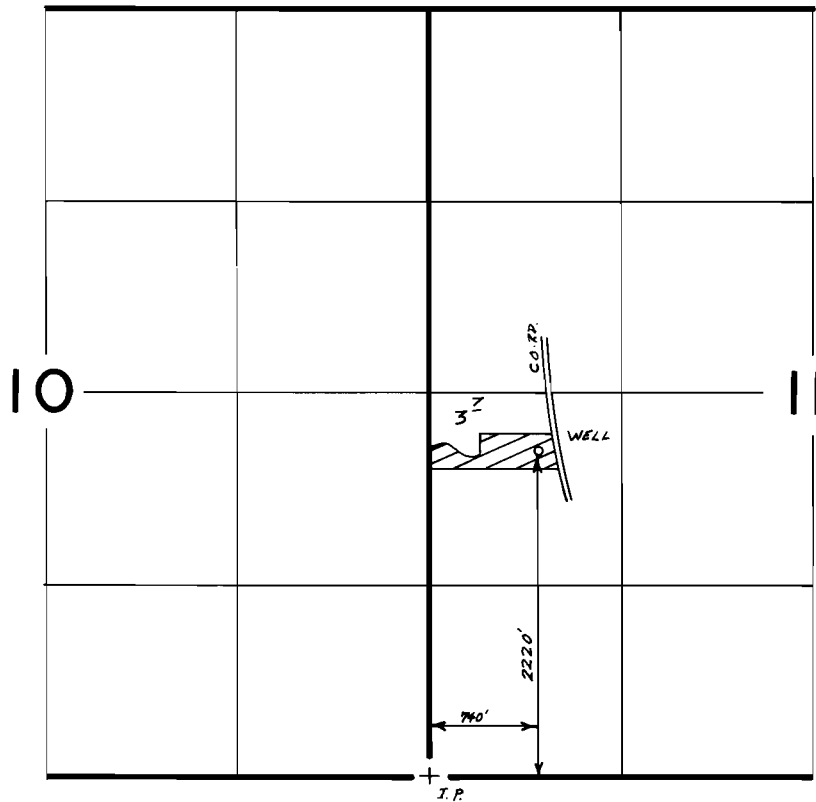

Scale 1" = 1320'

FINAL PROOF SURVEY
UNDER

Application No. G-10605 Permit No. G-9723...
IN NAME OF

THOMAS MERRITT SUGDEN

Surveyed Oct. 17, 1984, by B.S. JAMES