


T. 6S., R. 18 & 2W., W.M.

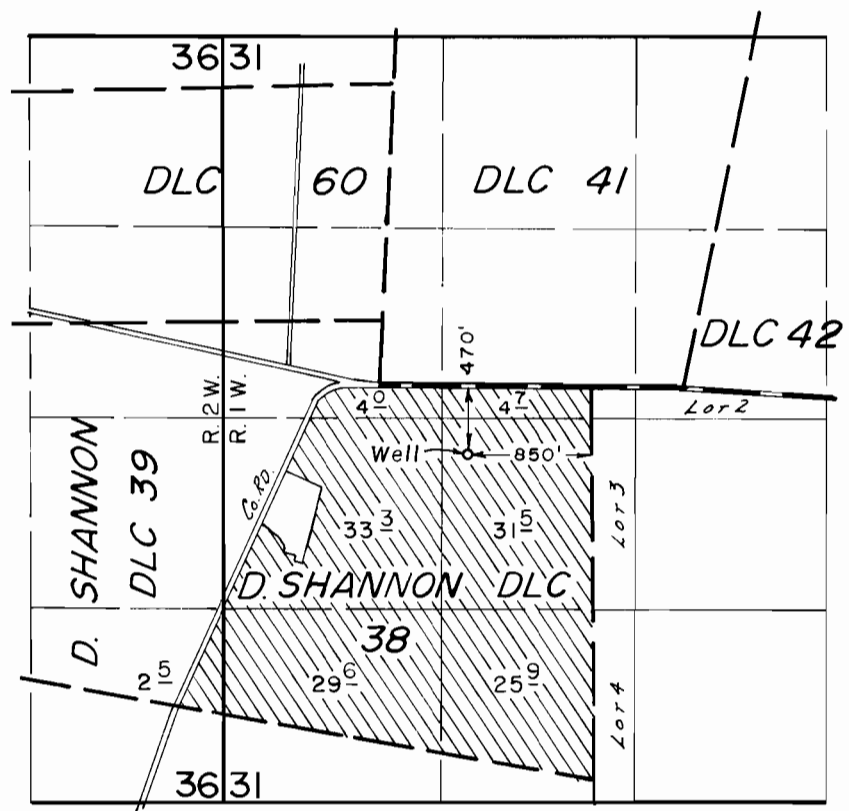

SCALE: 1"=1320'

FINAL PROOF SURVEY
UNDER

Application No. G-10608 Permit No. G-9617.....
IN NAME OF

.....WESLEY J. JOHNSON.....

Surveyed July..23... 19.84, by B.W. BISHOP.....