


T.1S, R.13&14E, W.M.

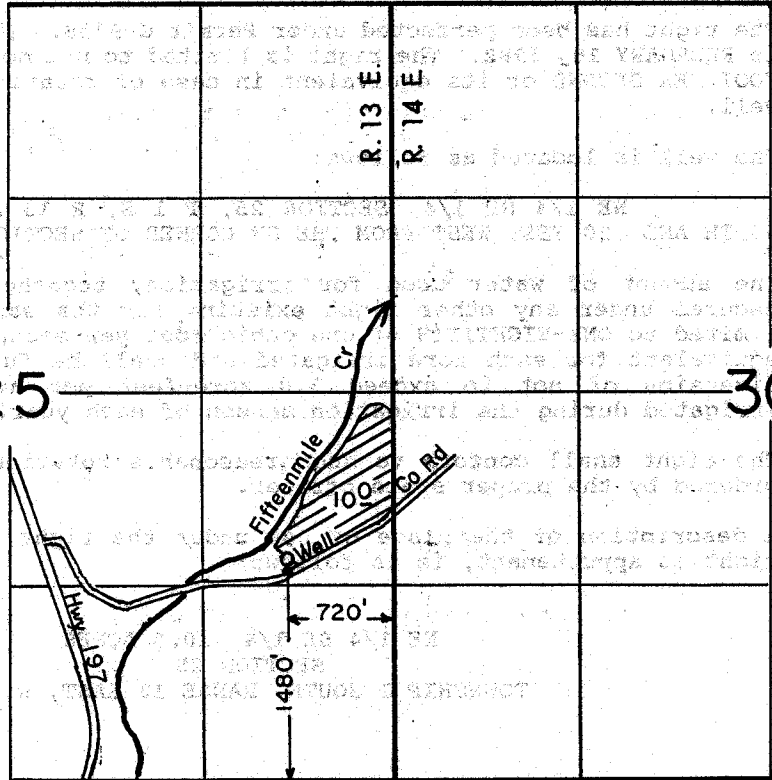

SCALE: 1" = 1320'

FINAL PROOF SURVEY

UNDER

Application No. G-10654.. Permit No. G-9758.....

IN NAME OF

WALTER V HANNA

Surveyed AUG 10, 1987, by V. L. CHURCH