


T.6S., R.2W., WM

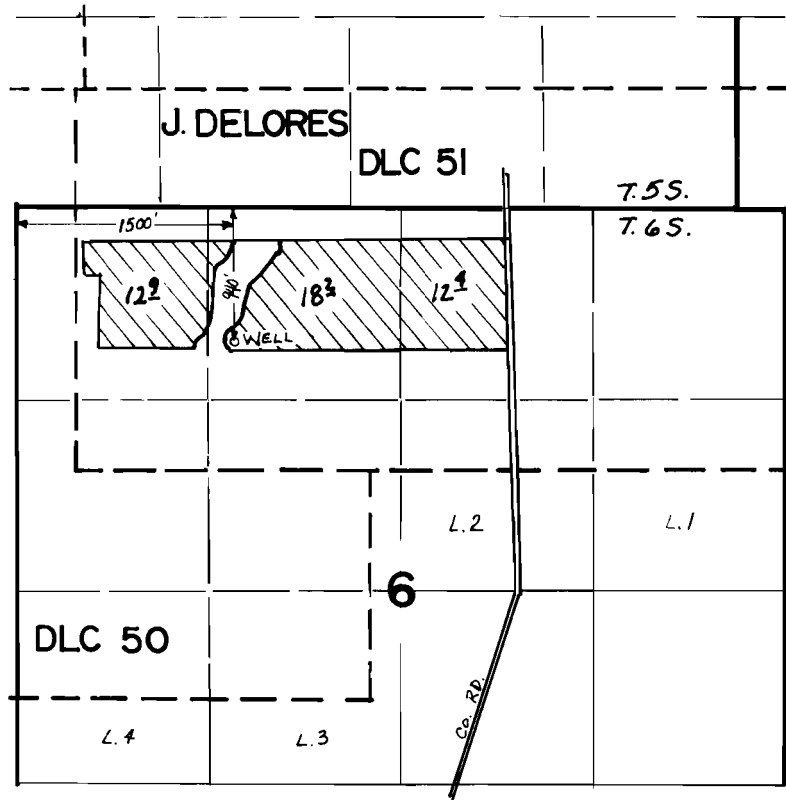

FINAL PROOF SURVEY UNDER

Application No. G.1066.Q. Permit No. G.9650....
IN NAME OF

JOHN J. ZIELINSKI

Surveyed OCT. 26, 1983, by M. CAHILL