


T.2S., R.4E., W.M.

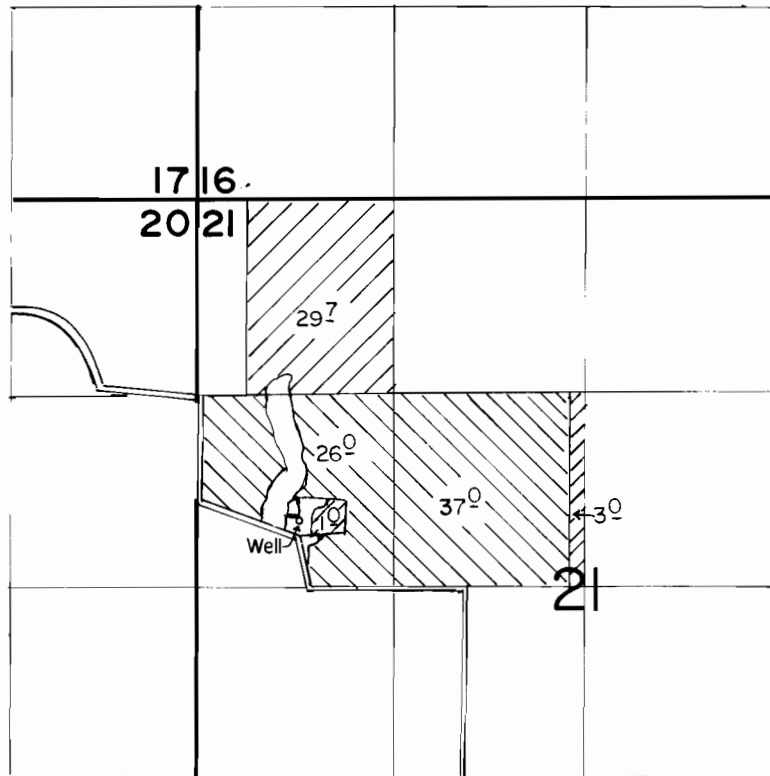

Well Located 450' N & 590' E From The W1/4 Corner Of Section 21

PRIMARY
SUPPLEMENTAL

SCALE: 1"=1320'

FINAL PROOF SURVEY UNDER

Application No. G-10720.. Permit No. G-9796.....
IN NAME OF

.....SHIRLEY B. MOLLER.....

Surveyed JULY 7..... 1987., by T.M. WARREN.....