


T. 4 S., R. 1 E., W. M.

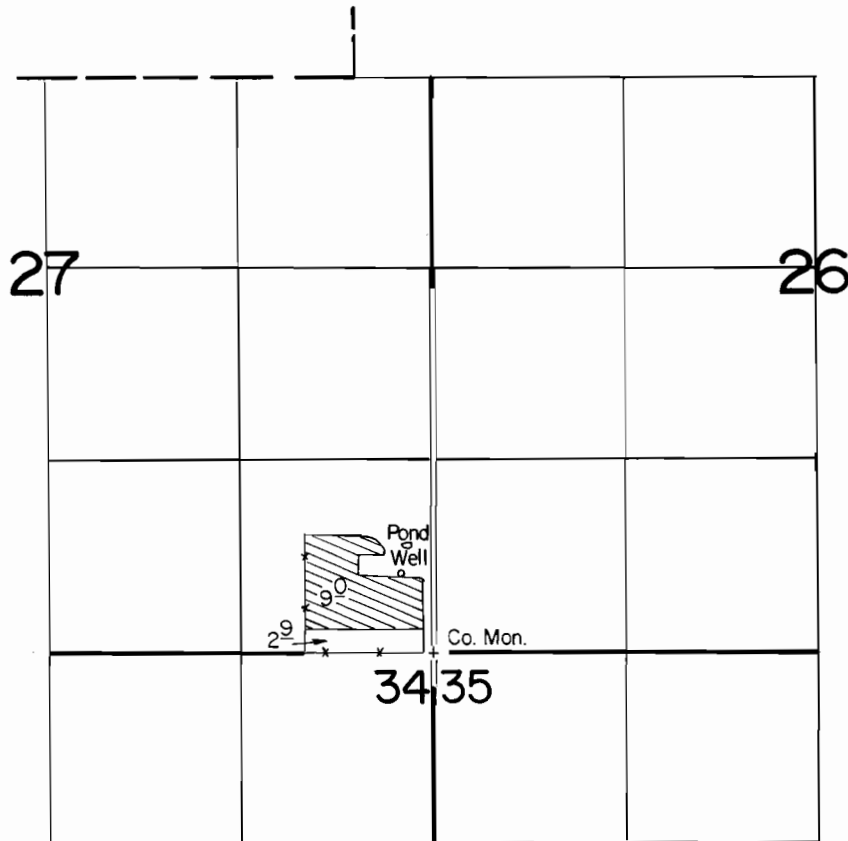

Well Loc.: 540' N. & 210' W. from SE Cor. Sec. 27.

Scale: 1" = 1320'

FINAL PROOF SURVEY UNDER

Application No. G-10891, Permit No. G-10082...
IN NAME OF

TIN H. WONG

Surveyed JULY 2, 1986, by T. Warren