


T.11S., R.5W., W.M.

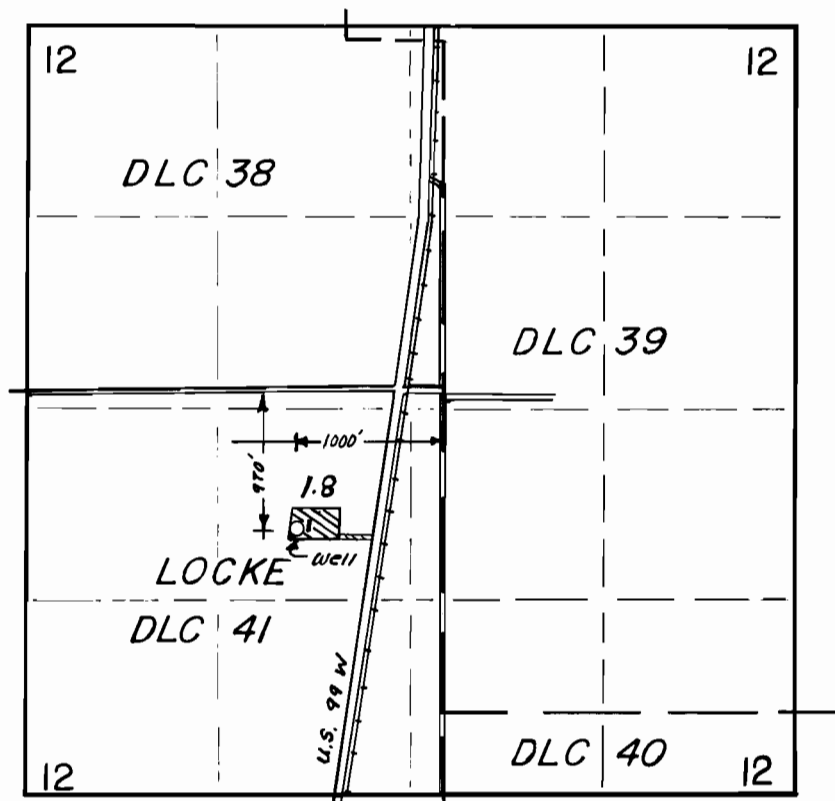

FINAL PROOF SURVEY
UNDER

Application No. G11042 Permit No. G10162
IN NAME OF

DEXTER A. LEONARD

Surveyed MAY 1 19.87, by T.M. Warren