


FINAL PROOF SURVEY

T.35S., R.14W., W.M.

SCALE: 1" = 1320 FEET

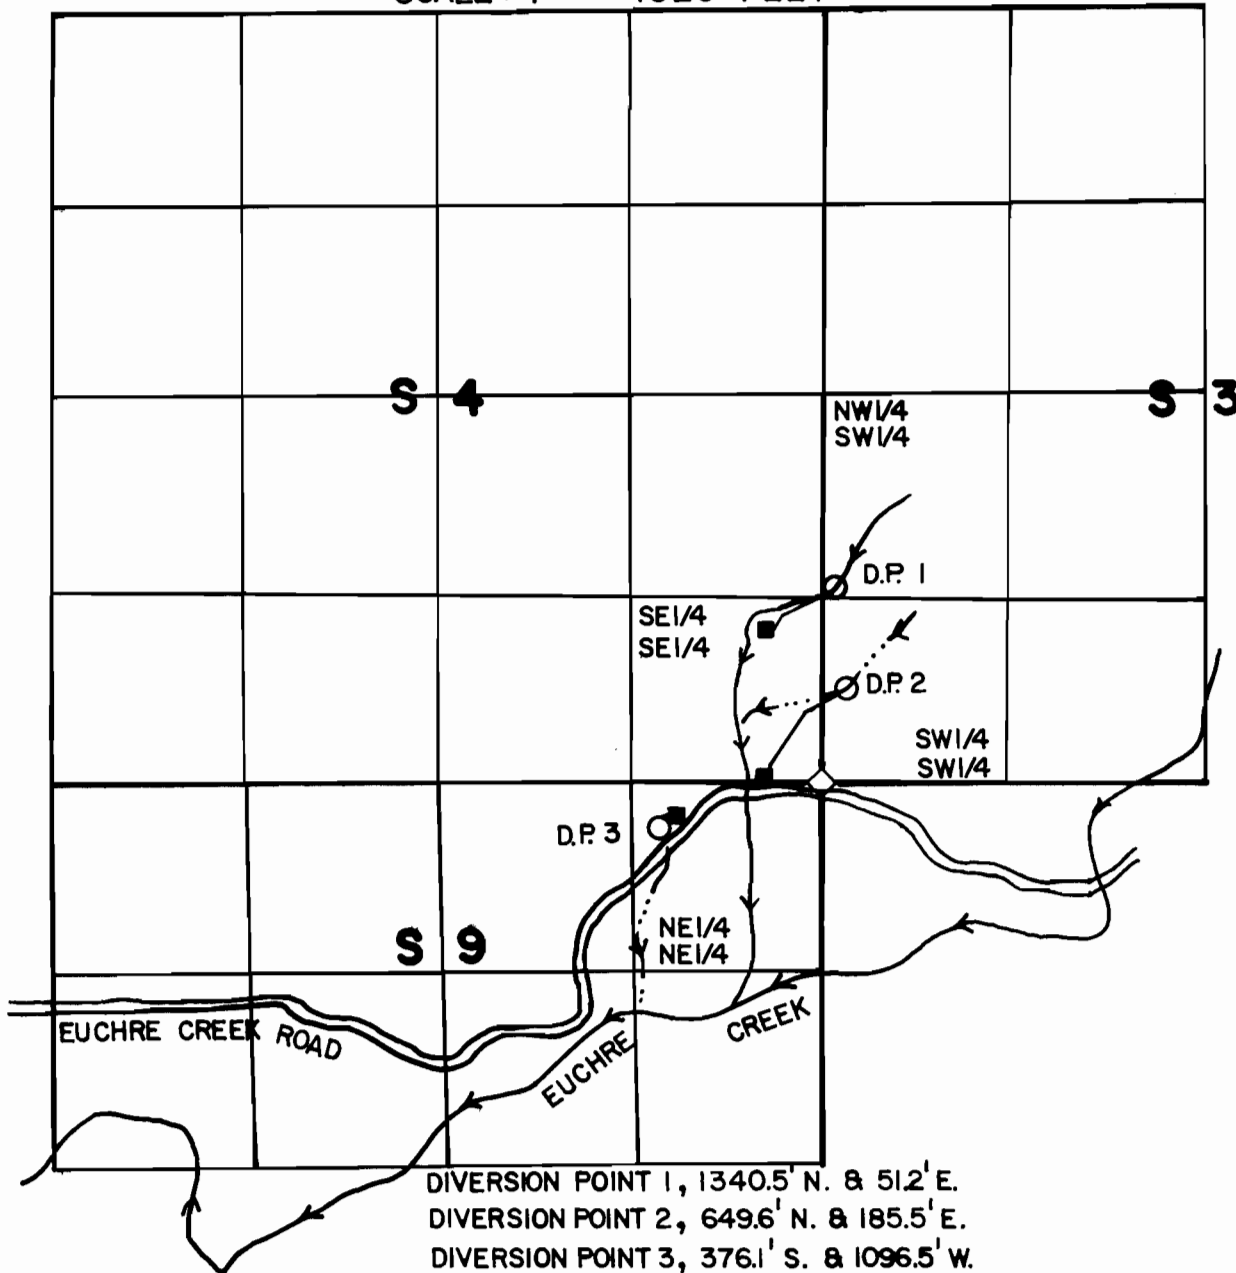

DIVERSION POINT 1, 1340.5' N. & 512' E.

DIVERSION POINT 2, 649.6' N. & 185.5' E.

DIVERSION POINT 3, 376.1' S. & 1096.5' W.

ALL TIES ARE TO THE BRASS CAP AT THE S.E. COR. OF SEC. 4.

APPLICATION NO. 70125 PERMIT NO. 50847

IN THE NAME OF JOHN MOORE

SURVEYED 10/89 BY THOMAS J. HOWIE, WRE 070.

THIS MAP SHOWS THE LOCATION OF A WATER RIGHT
ONLY AND HAS NO INTENT TO PROVIDE DIMENSIONS
OR LOCATION OF PROPERTY OWNERSHIP LINES.

