


T.40S.,R.3W.,W.M.

Application No. G-11092
Permit No. G10239

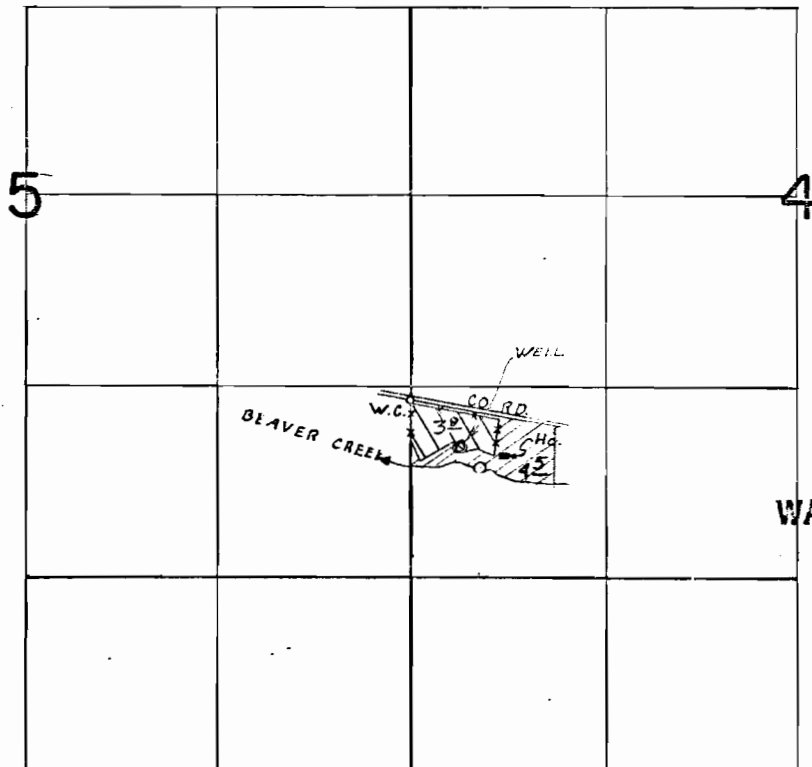

RECEIVED

SEP 22 1983

WATER RESOURCES DEPT.
SALEM, OREGON



PRIMARY IRRIGATION 45 ACRES

WELL LOCATION: 900' N. & 350' E.
FROM THE SW COR. SEC. 4



SUPPLEMENTAL IRRIGATION 38 ACRES

FINAL PROOF SURVEY

UNDER

4" = 1 MILE

~~Application No. 47119 Permit No. 35282 - Certificate No. 45394~~
IN NAME OF ~~Priority 6-23-74~~

~~JOSEPH P. BRADSHAW~~

~~Surveyed MAY 6 1976, by C.R. KING~~

JOSEPH P. & VIVIAN O. BRADSHAW