


T. 4 N., R. 1 W., W.M.

Sec. 30

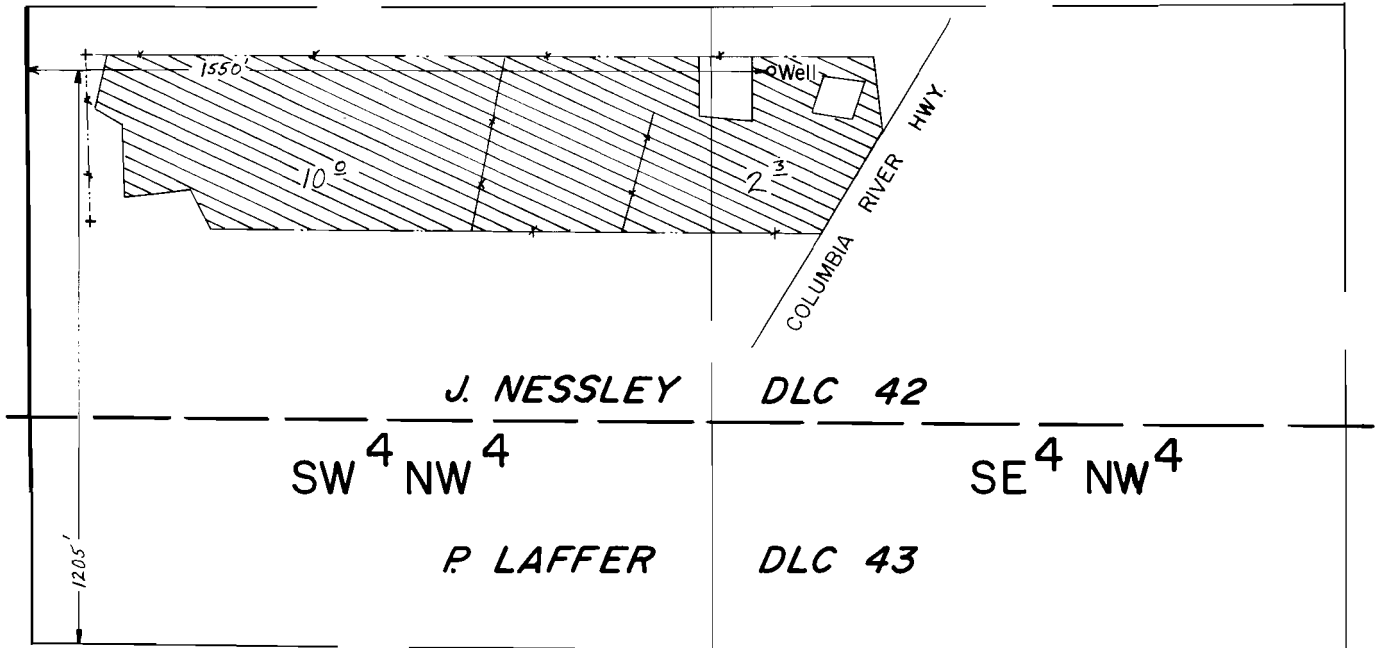

Scale. : 1" = 400'

FINAL PROOF SURVEY UNDER

Application No. G-11141... Permit No. G-10264...
IN NAME OF

HERMAN L. & SELMA L. McNEELY

Surveyed JUNE 4... 1986., by T. Warren.....