


T.15S., R.4W., W.M.

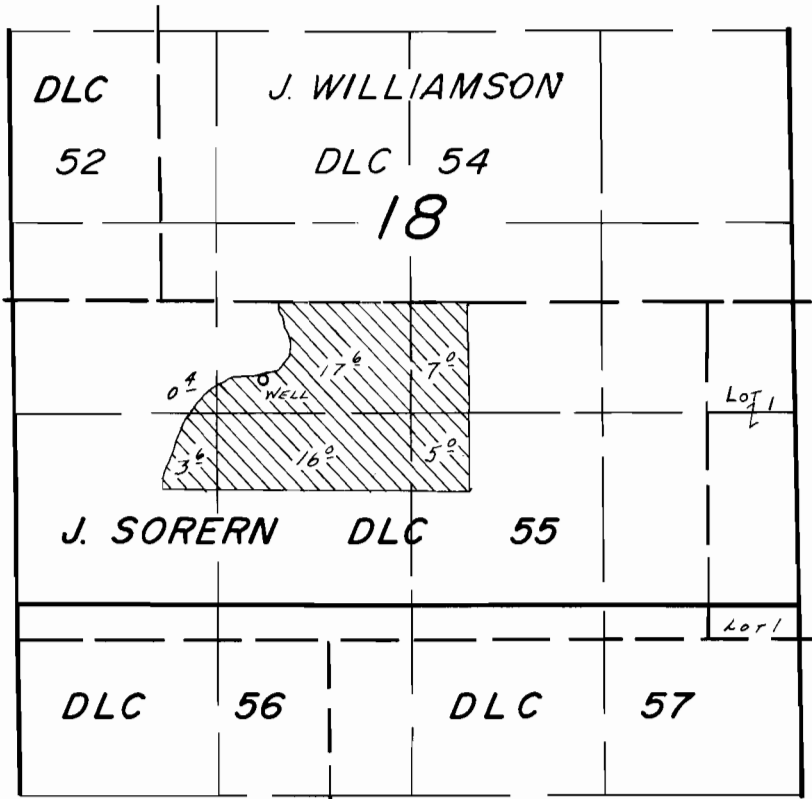

WELL LOC.: 540'S. & 700'E. FROM SW COR. J. WILLIAMSON DLC 54

Scale: 1" = 1320'

FINAL PROOF SURVEY
UNDER

Application No. G-11227 Permit No. G-10350
IN NAME OF
JAGER FARMS, INC.

Surveyed May 7 1985, by P. Pagter
Oct. 6 1986 B.W. BISHOP