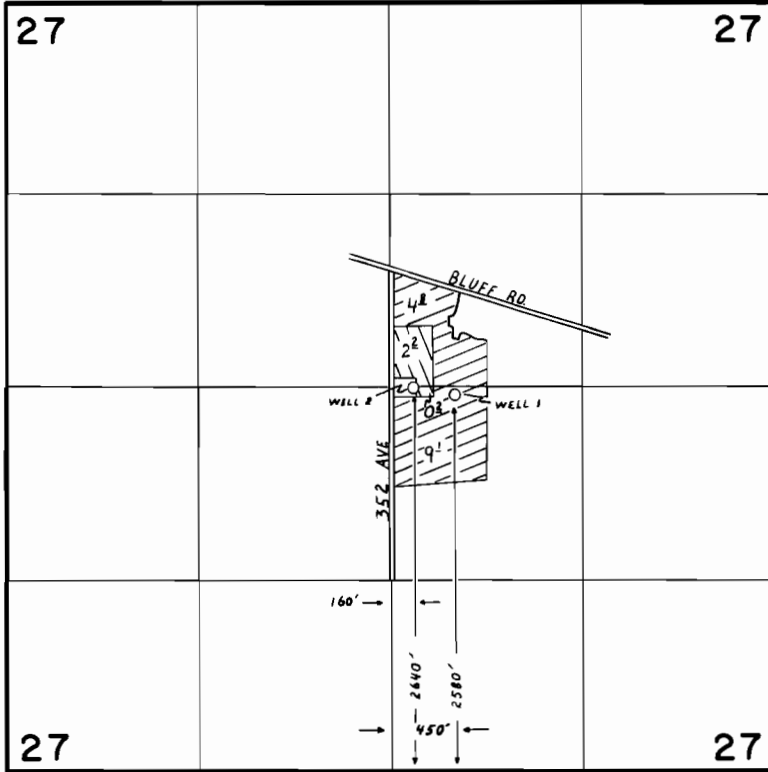

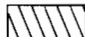


# T1S, R4E, WM



1" = 1320'

## FINAL PROOF SURVEY UNDER

-  WELL 1  
IRR.
-  WELL 1 & 2  
CONTAINER STX, REL. NURS. USE,  
IRR.

Application No. G-11282.. Permit No. G-10454...  
IN NAME OF

.....ROBERT W. LOOMIS.....

Surveyed JUNE 15, 1987., by T.M. WARREN...