


T.39S., R. 8 E., W.M.

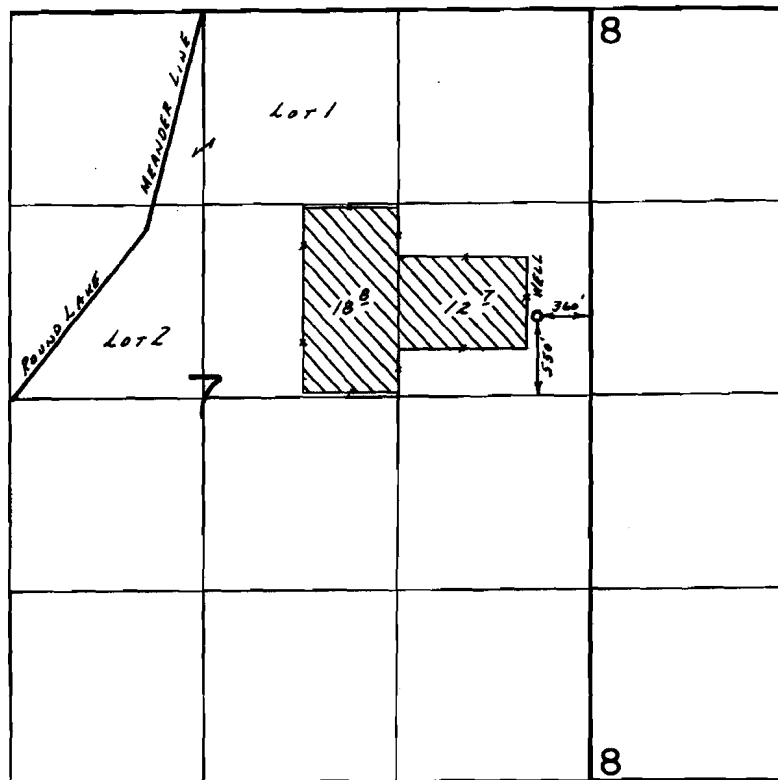

SCALE: 1" = 1320'

FINAL PROOF SURVEY
UNDER

Application No. G-11310. Permit No. G-10432..
IN NAME OF

.....JACK ARMSTRONG.....

Surveyed ..Aug. 19. 19.87., by B.S. JAMES.....

App. H. L. & Misc. 6/2/88