


210560
65475

T. 6N., R. 34E., W.M.

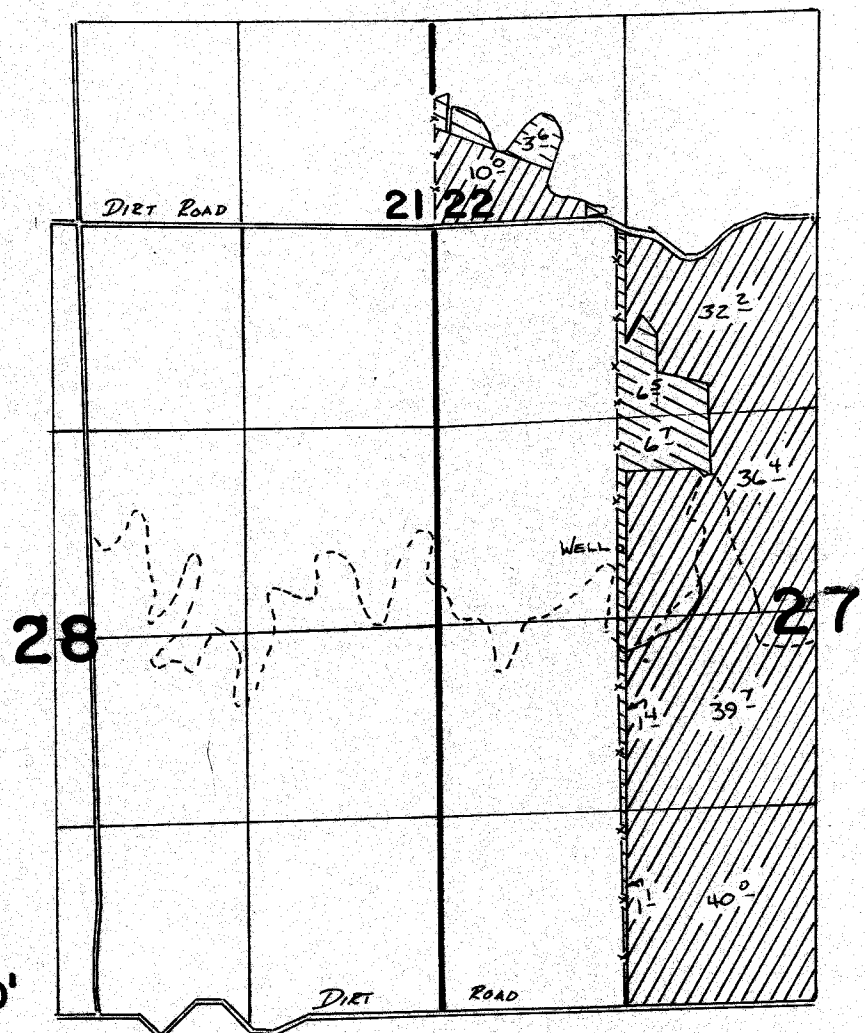

SCALE 1" = 1320'

WELL LOC: 470' N. & 1250' E FROM W 1/4 COR SEC 27

 PRIMARY
  SUPPLEMENTAL

FINAL PROOF SURVEY UNDER

Application No. **G:11329** Permit No. **G:10560**
IN NAME OF

RICHARD FULGHAM

Surveyed **3-2** 19**87**, by *V.C. Chubb*