


# T. 3 N. R. 34 E. W.M.

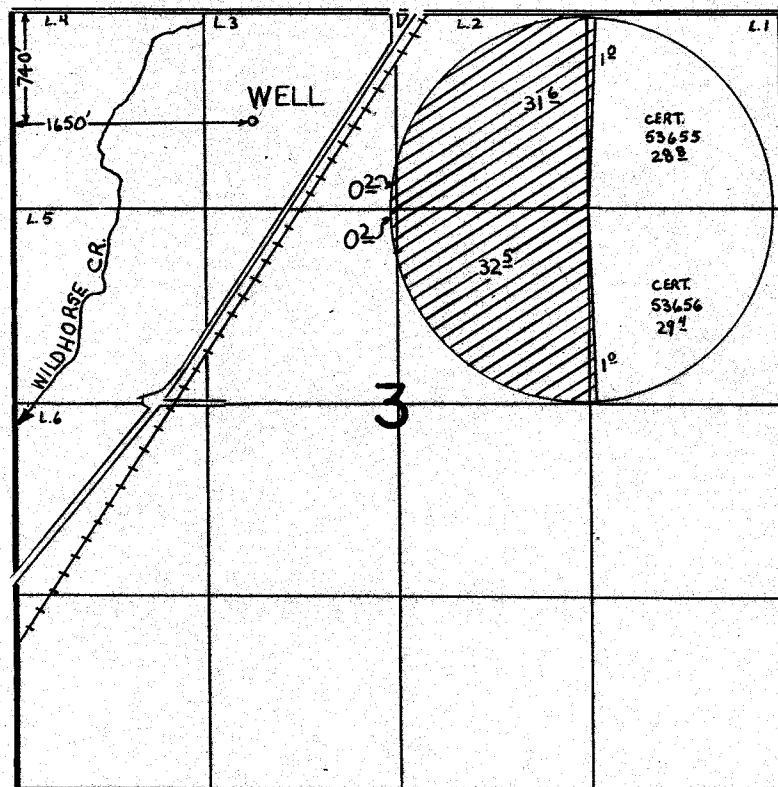

SCALE 1" = 1320'



## FINAL PROOF SURVEY UNDER

Application No. G-11361 Permit No. G-10540  
IN NAME OF

B.L. DAVIS RANCHES, INC.

Surveyed JULY 15, 1986, by V. CHURCH