



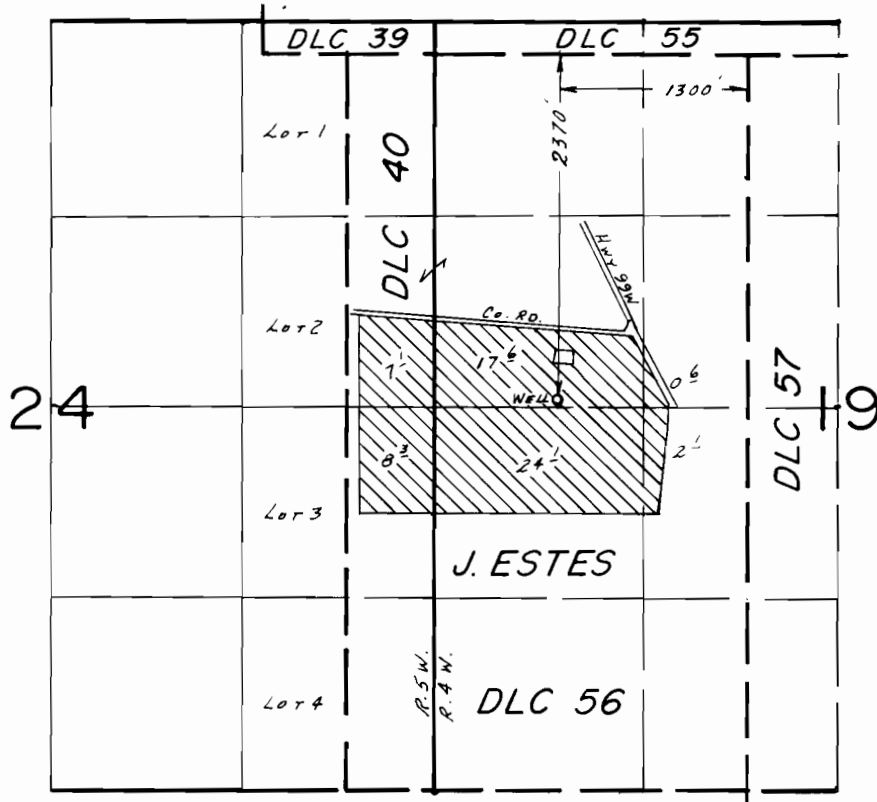

SCALE: 1" = 1320'

FINAL PROOF SURVEY
UNDER

95

Application No. G:11359 Permit No. G:10574...
IN NAME OF

..... JAMES J. MUNSON

Surveyed Oct., 8..... 19.86, by ..B.W..BISHOP.....

1-20-87
BWB

PTS 1986D