


# T. 28 S., R. 14 W., W.M. SECTION 28

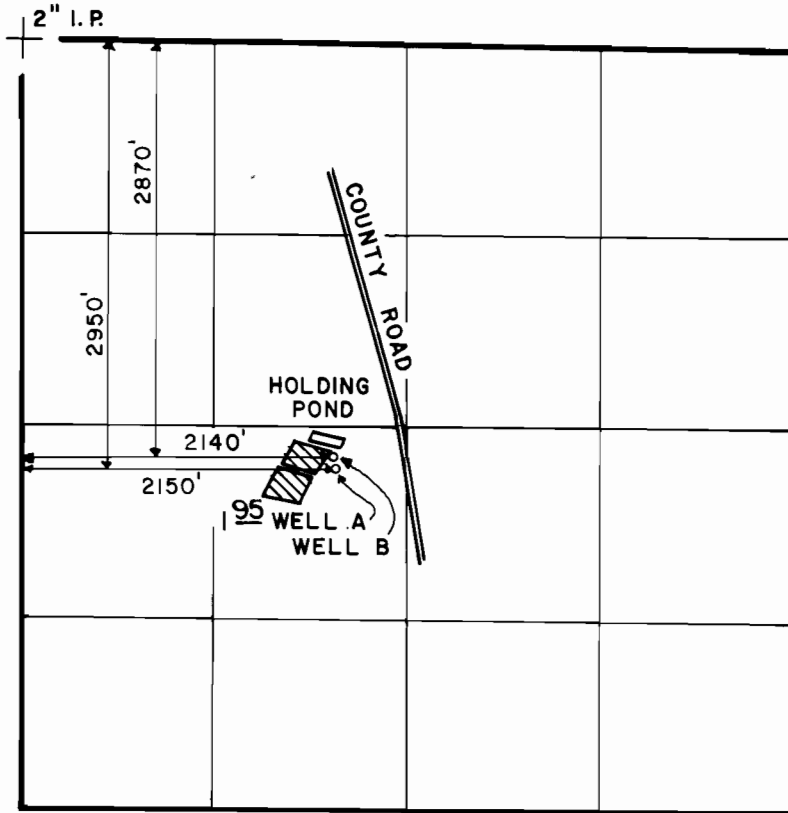

SCALE: 4" = 1 MILE

## FINAL PROOF SURVEY UNDER

Application No. G-11414. Permit No. G-10520...  
IN NAME OF

LOUIS PALLIN

Surveyed JULY 11 1986, by J. M. SCHMORDE