



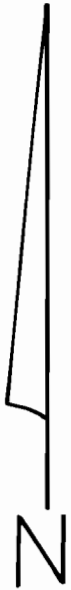

T. 6 N. R. 36 E. W.M.

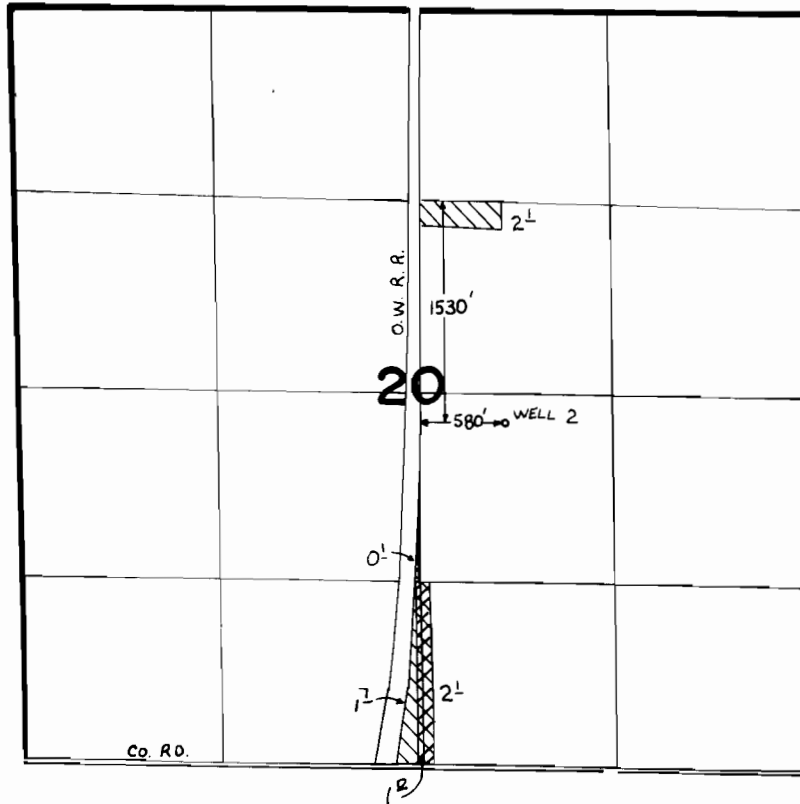


Scale 1"=1320'



PRIMARY WELL 1 - SUPPLEMENTAL WELL 2 
 SUPPLEMENTAL FROM WELL 1 

FINAL PROOF SURVEY UNDER

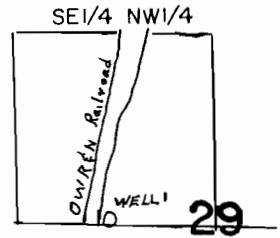

Well 2640'S & 1950' E From NW Cor.
Section 29

Application No. G.11.488 Permit No. G.10608...
IN NAME OF

MARTIN A. & JANET A. BUCHANAN

Surveyed Nov. 24, 1986, by V. Church.....