


T. 1N., R. 32E., W.M.

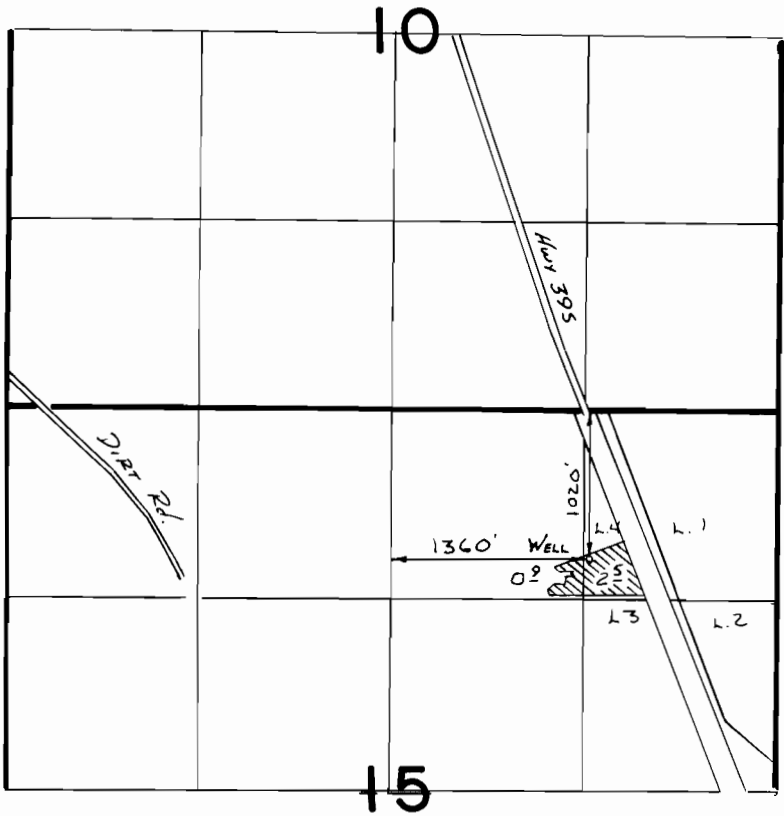

SCALE 1" = 1320'

**FINAL PROOF SURVEY**  
UNDER

Application No. **G:11497** Permit No. **G:10611**  
IN NAME OF

**JAMES M. BROWN**

Surveyed **7-1** 19**87**, by **V.L. Church**