
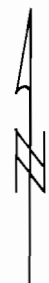


T.3S., R.38E., W.M.

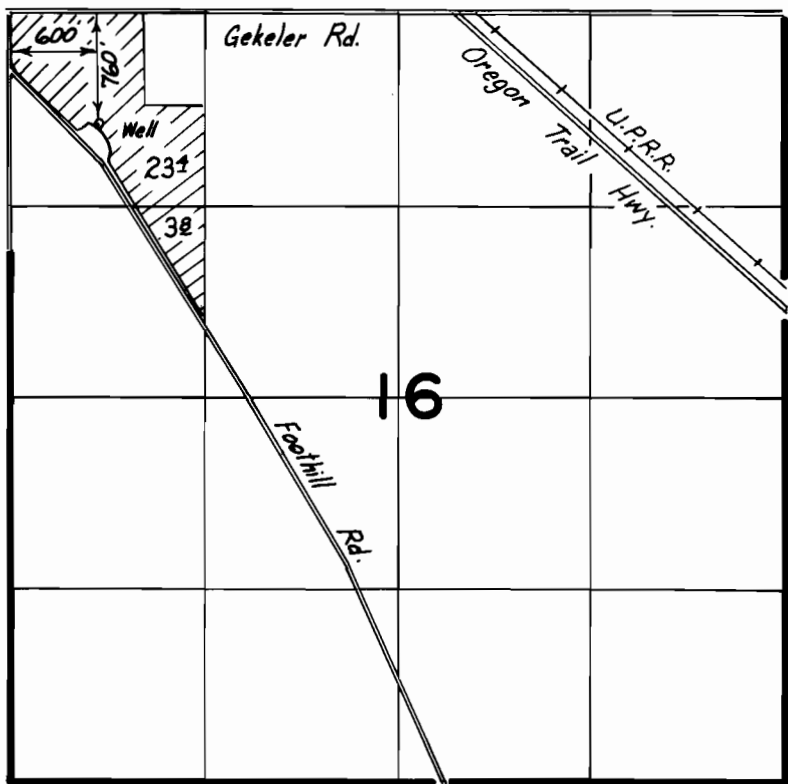

Scale: 1" = 1320'

FINAL PROOF SURVEY UNDER

Application No. **G11587**... Permit No. **G10697**...
IN NAME OF

RAY E. & HELEN M. CROSSEN

Surveyed *11-2*..... 19.87., by *Vern Church*.....