


# T. 30S., R. 3W., W.M.

## SECTION 26

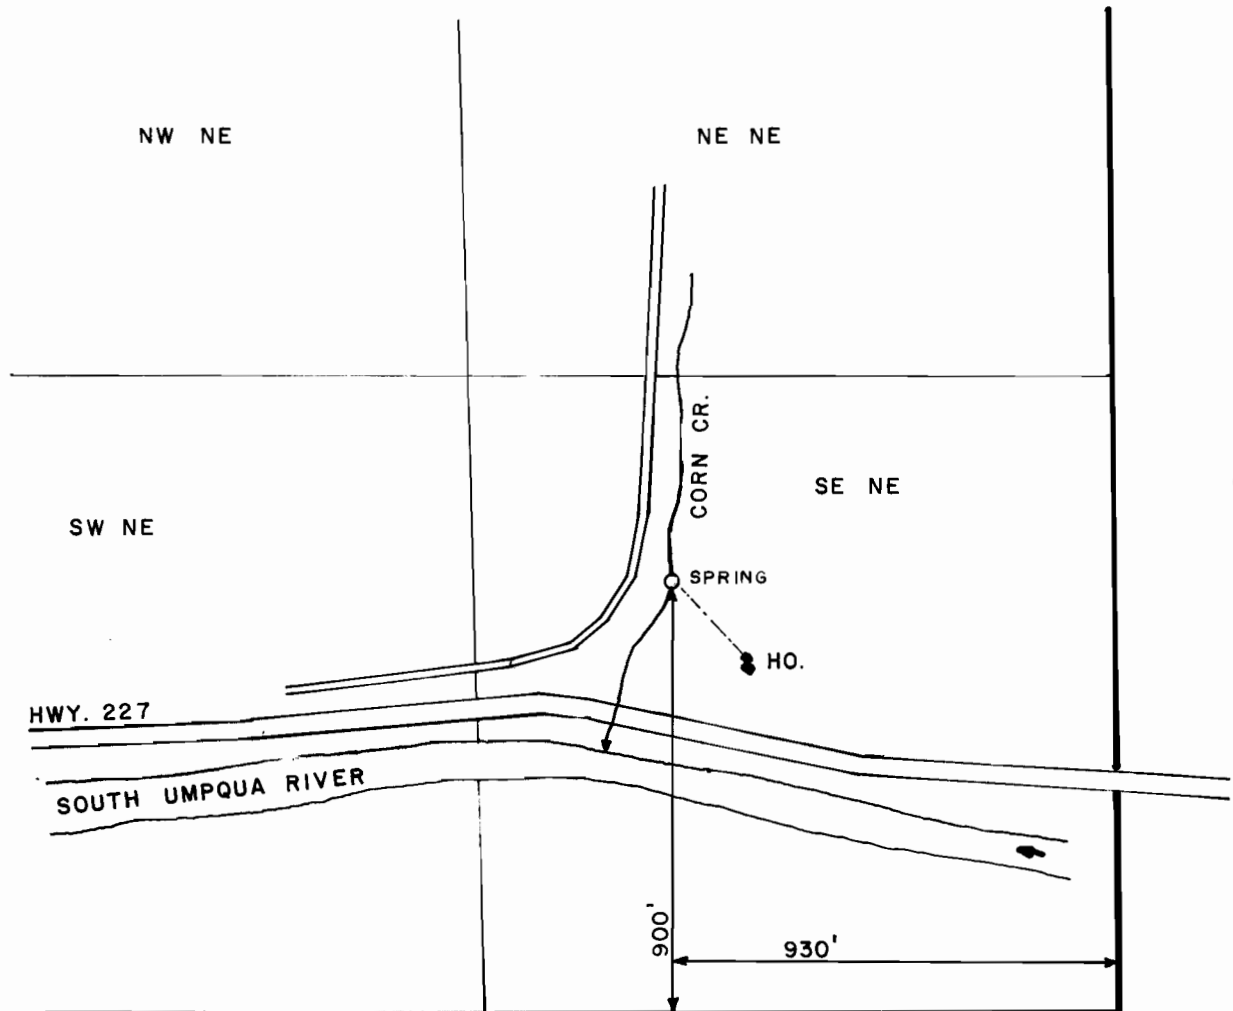

SCALE: 1" = 400'

### FINAL PROOF SURVEY UNDER

Application No. 64626.. Permit No. 47502.....  
IN NAME OF

**EVELYN C. WOHLERS**

Surveyed JUNE 26, 1986., by J.M. SCHMORDE..