


T. 26 S., R. 3 W., W.M.

SECTION 19

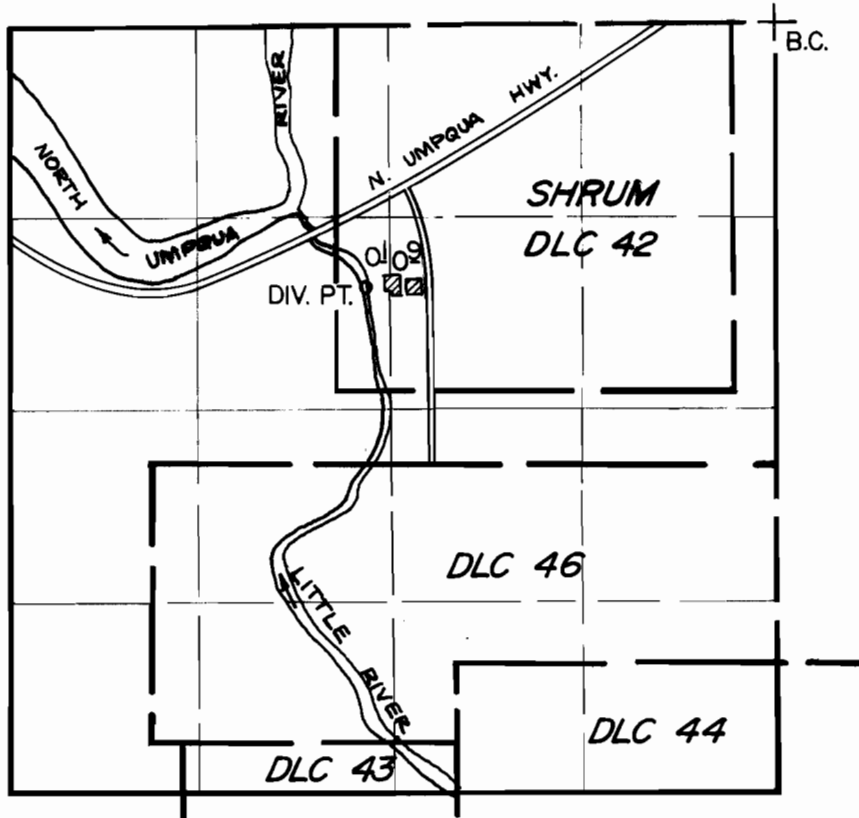

DIV. PT. IS LOCATED 1830' S. & 2840' W. FROM NE CORNER SEC. 19

SCALE: 4" = 1 MILE

FINAL PROOF SURVEY UNDER

Application No. ..65039.. Permit No. ...47787.....
IN NAME OF

.....**PETER B. SERAFIN**.....

Surveyed ..SEPT. 16, 1986., by ...J.M. SCHMORDE..