


T.8S., R.25E., W.M.

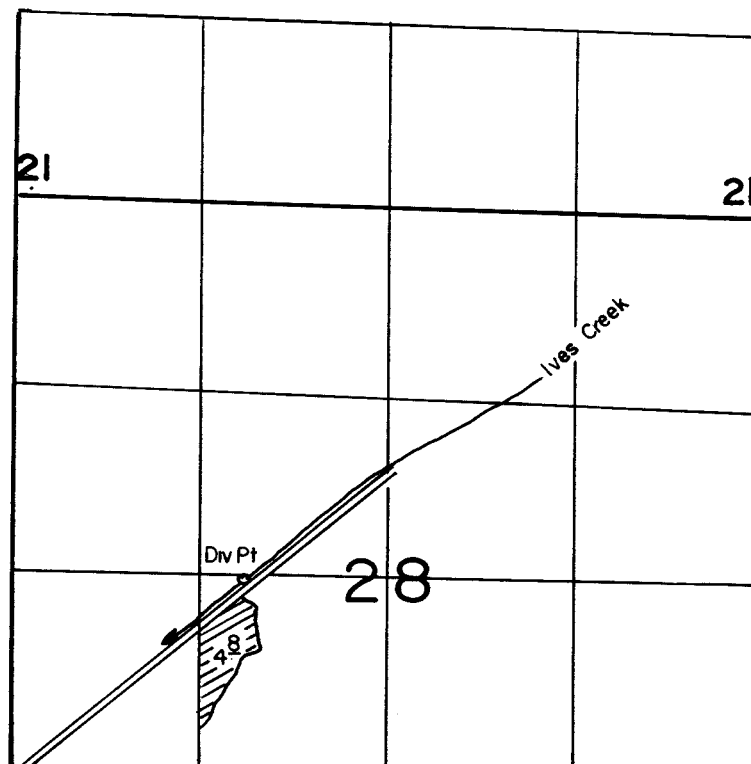

DIV PT LOCATED 50'S & 970' W FROM CENTER 1/4 COR SEC 28

SCALE: 1"=1320'

FINAL PROOF SURVEY
UNDER

Application No. 65060... Permit No. 47797.....
IN NAME OF

...RICHARD A. & BARBARA L. FOSTER

Surveyed MAY...12... 1987., by V.L.CHURCH.....