


T.30S., R.3W., W.M.  
SECTION 28

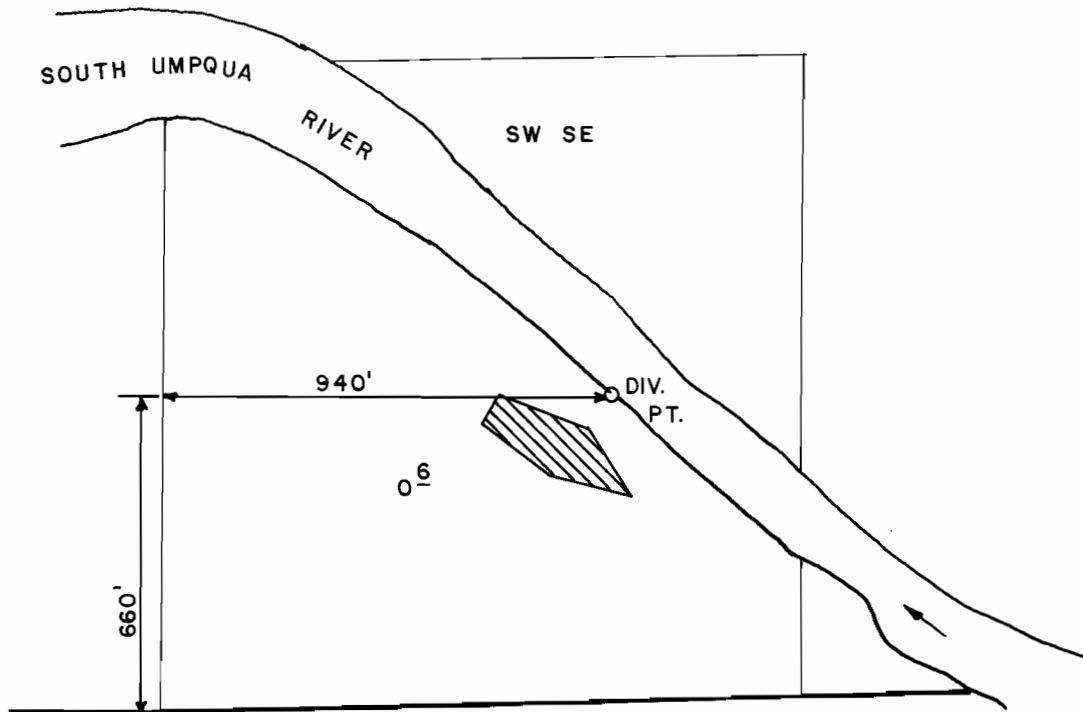

SCALE: 1" = 400'

**FINAL PROOF SURVEY**  
UNDER

Application No. 65213 Permit No. 47656  
IN NAME OF

**RANDOLPH D. & GLORIA J. LARSON**

Surveyed JUNE 26, 1986, by J. M. SCHMORDE.