


T. 28 S., R. 13 W., W. M.

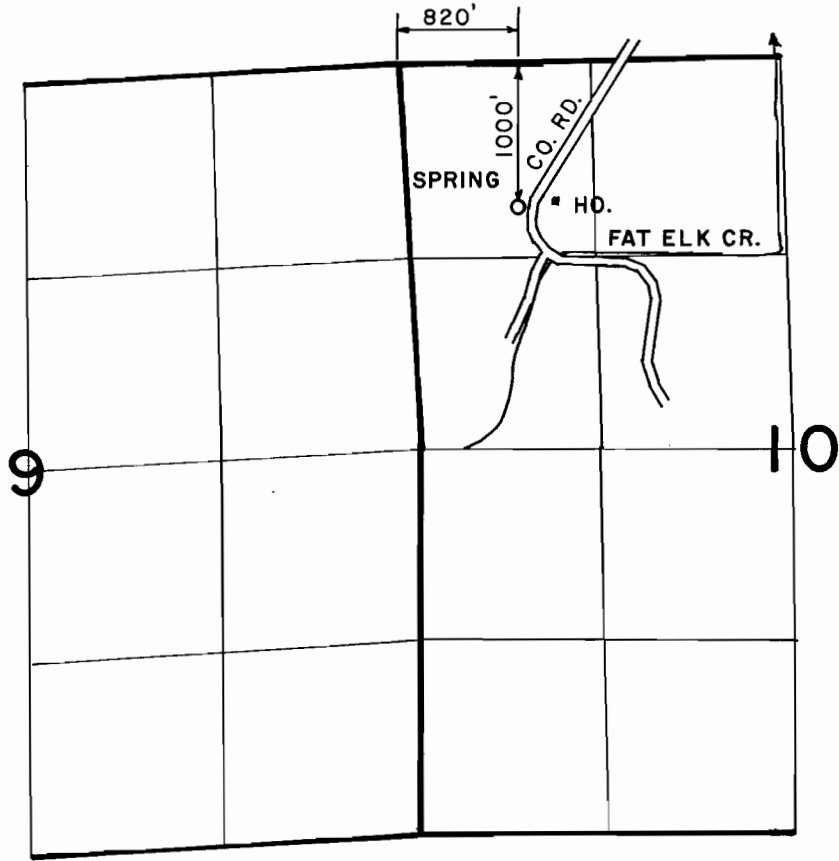

SCALE: 4" = 1 MILE

FINAL PROOF SURVEY
UNDER

Application No. 65250 Permit No. 47929
IN NAME OF

JOHN P. & FRANCES L. PETERSON

Surveyed SEPT. 10, 1985, by J.M. SCHMORDE.