


# T. 27S., R. 6W., W. M.

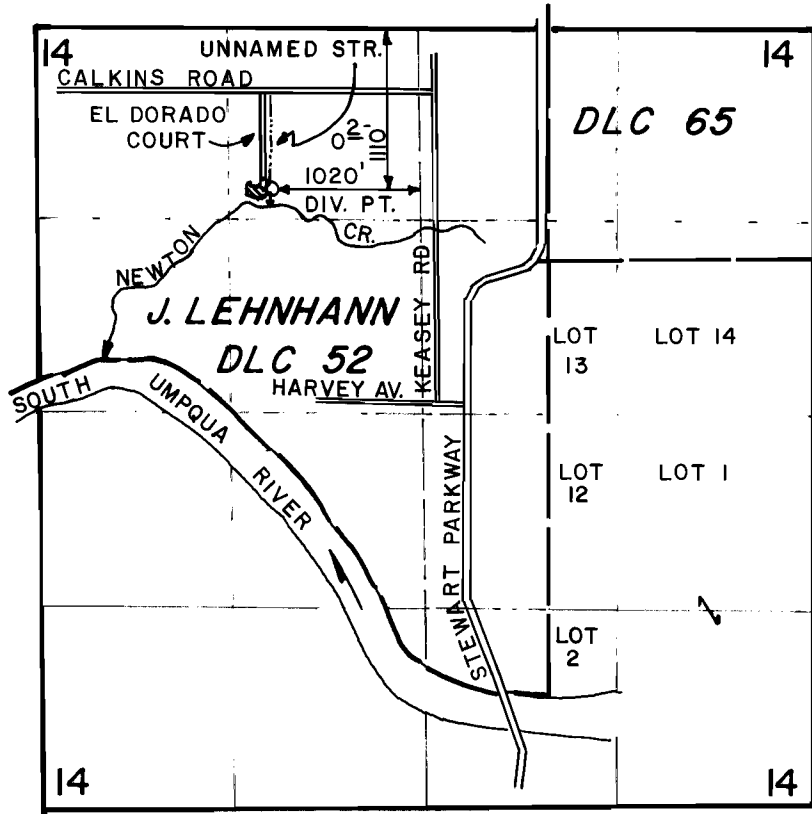

SCALE: 4" = 1 MILE

## FINAL PROOF SURVEY UNDER

Application No. 65491..... Permit No. 47974.....  
IN NAME OF

**WAYNE A. AND MEARLINE I. SCHMIDT**

Surveyed MAY 9..... 1984, by L. E. CASHION.....