


T. 27S., R. 5W., W.M.

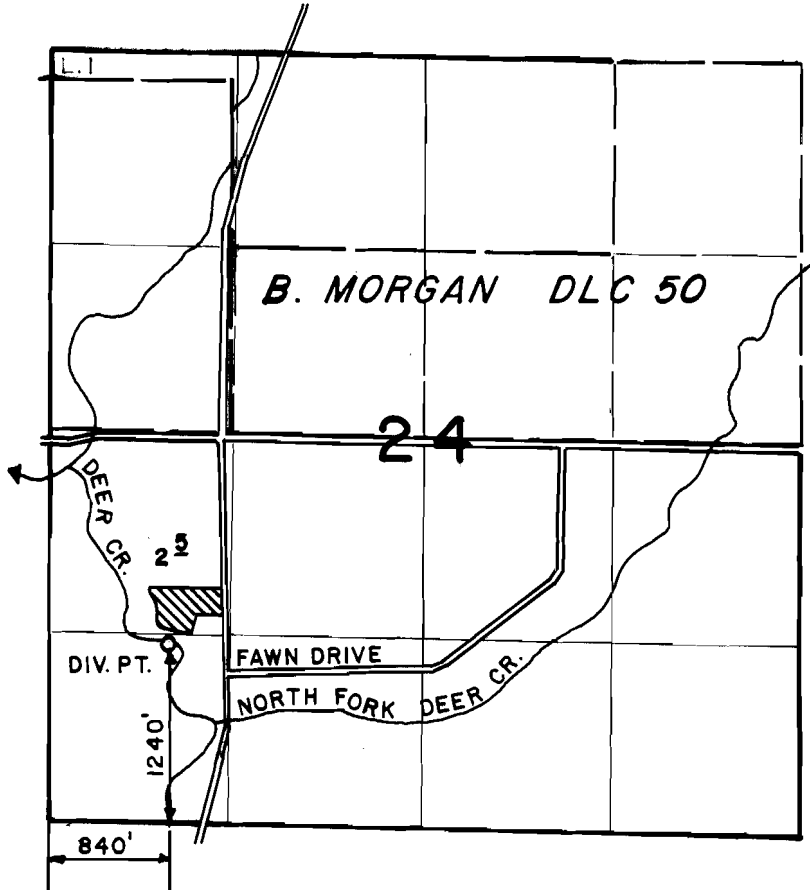

SCALE: 4" = 1 MILE

FINAL PROOF SURVEY
UNDER

Application No. 65887 Permit No. 48025
IN NAME OF

C. L. MALONE

Surveyed SEPT. 23 1987, by J. M. SCHMORDE