


T.27S., R.5W., W.M.

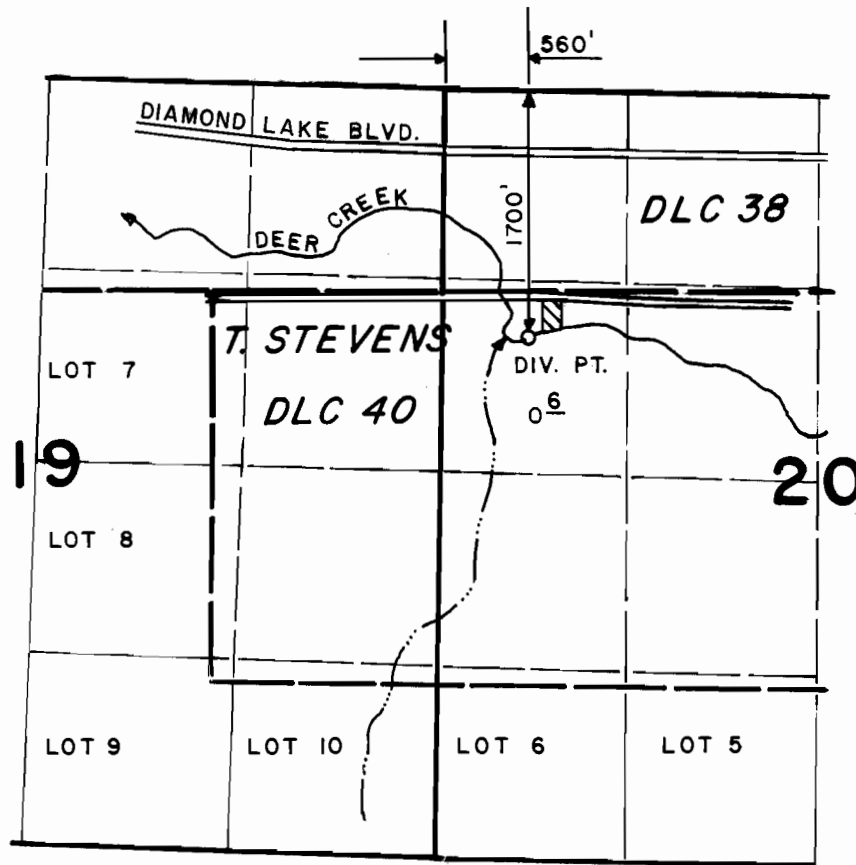

SCALE: 4" = 1 MILE

**FINAL PROOF SURVEY**  
UNDER

Application No. 65982... Permit No. 48034  
IN NAME OF

**ANTHONY SANADA**

Surveyed OCT. 23. 1987., by J.M. SCHMORDE.