


T. 27S., R. 5W., W.M.

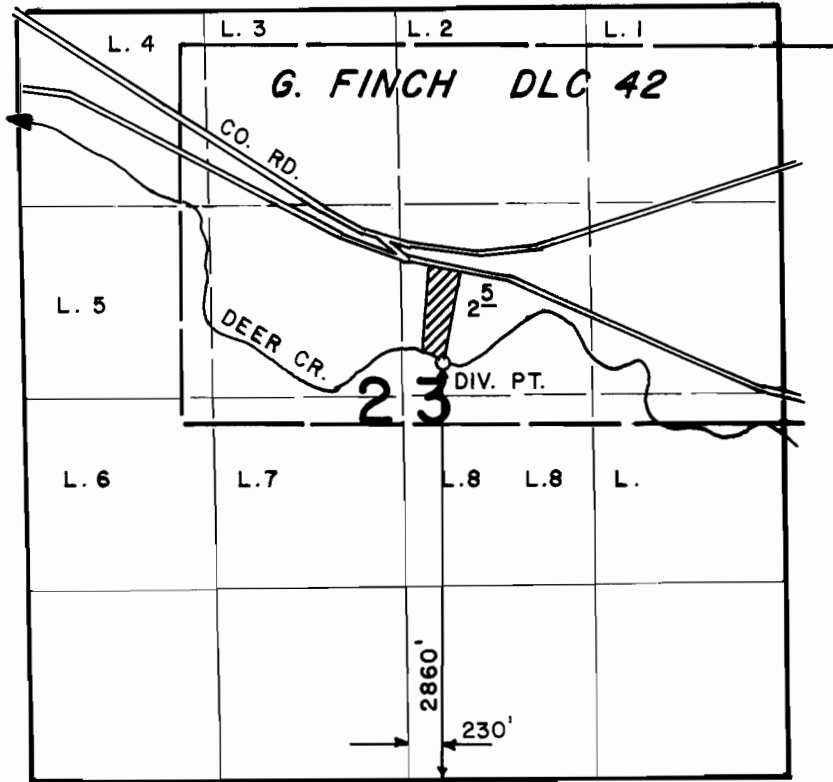

SCALE: 4" = 1 MILE

FINAL PROOF SURVEY
UNDER

Application No. 66601... Permit No. 48085.....
IN NAME OF

CHARLES R. STRICKLAND

Surveyed OCT. 23 1987., by J. M. SCHMORDE