
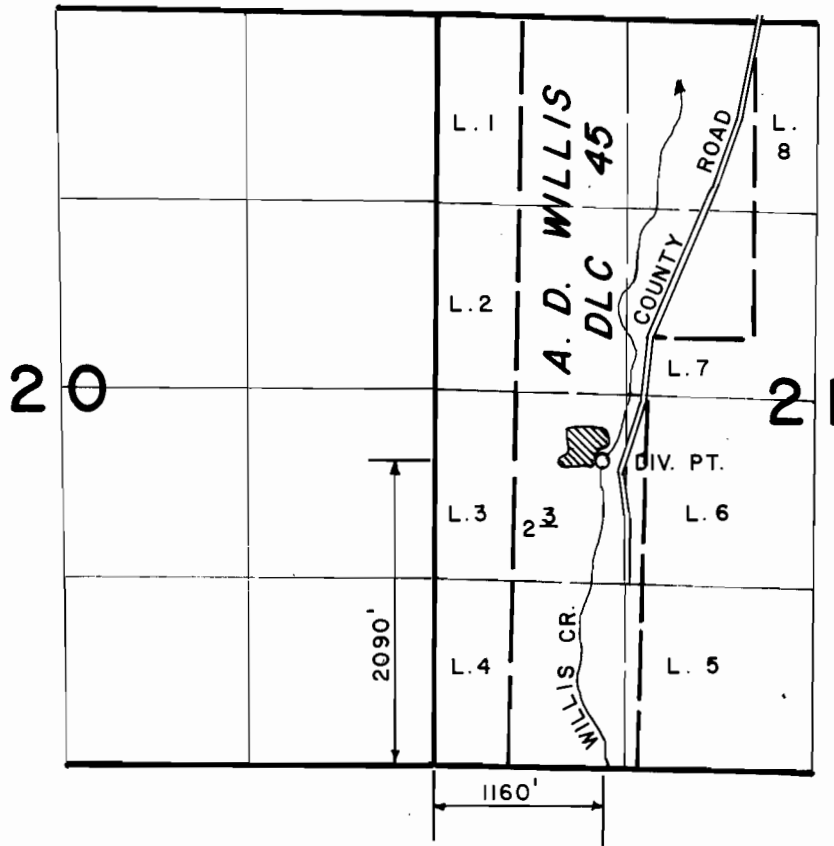


T. 29 S., R. 6 W., W. M.

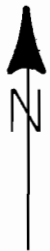

SCALE: 4" = 1 MILE

FINAL PROOF SURVEY
UNDER

Application No. 67341... Permit No. 48240.....
IN NAME OF

BERTHA MARIE HAAS

Surveyed JUNE 17, 1987, by J.M. SCHMORDE.