


T.6S., R.1E., W.M.

Sec. 1

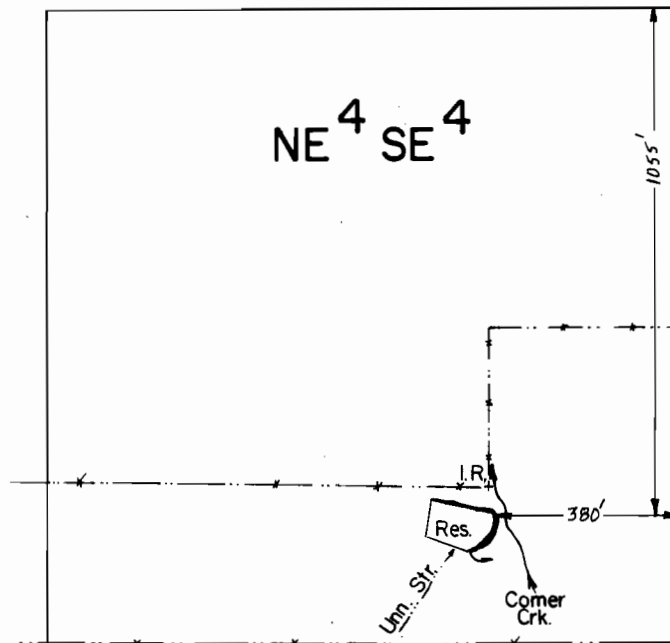

Scale : 1" = 400'

FINAL PROOF SURVEY
UNDER

Application No. R-67547 Permit No. R-9391
IN NAME OF

ROBERT D. FRIAS

Surveyed JUNE 9, 1986, by J. Warren

PTS-1986-A
TMW 1/14/87