



# T.7 S., R.38 E., W.M.

Mansfield Ditch

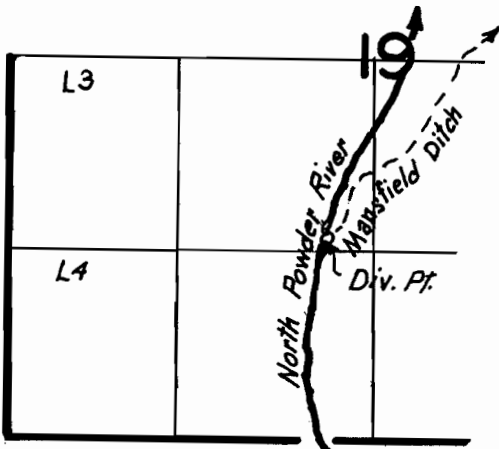

The location of the div. pt. is 1400' N. & 2310' E. of the SW cor. sec. 19.

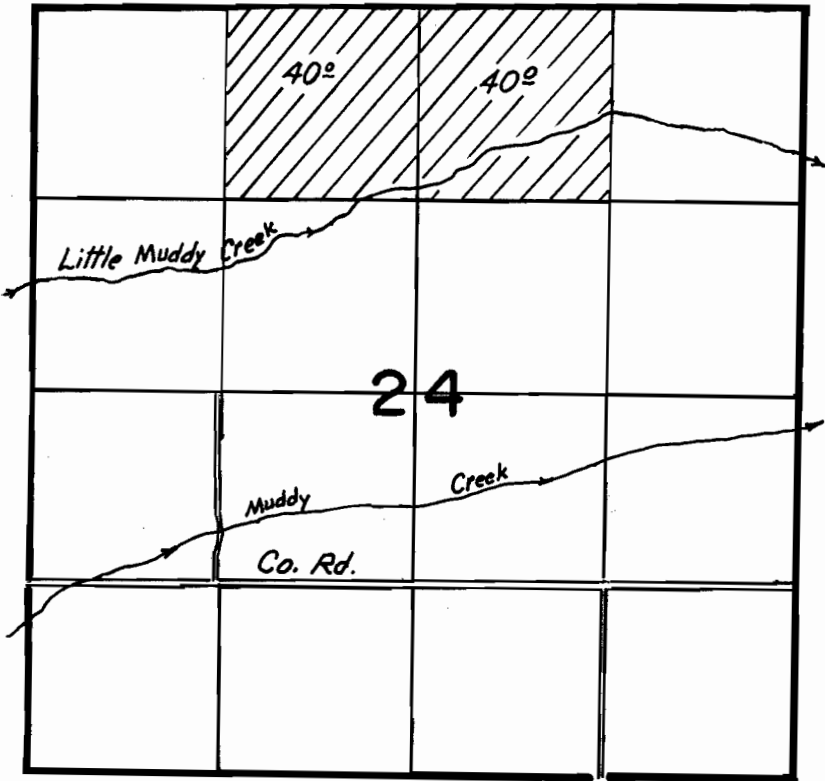

Scale: 1" = 1320'

## FINAL PROOF SURVEY

UNDER

Application No. 67733 Permit No. 48282

IN NAME OF

ALAN MAXWELL

Surveyed 6-3 1987, by Vern Church