


T. 30 S., R. 2 W., W. M.

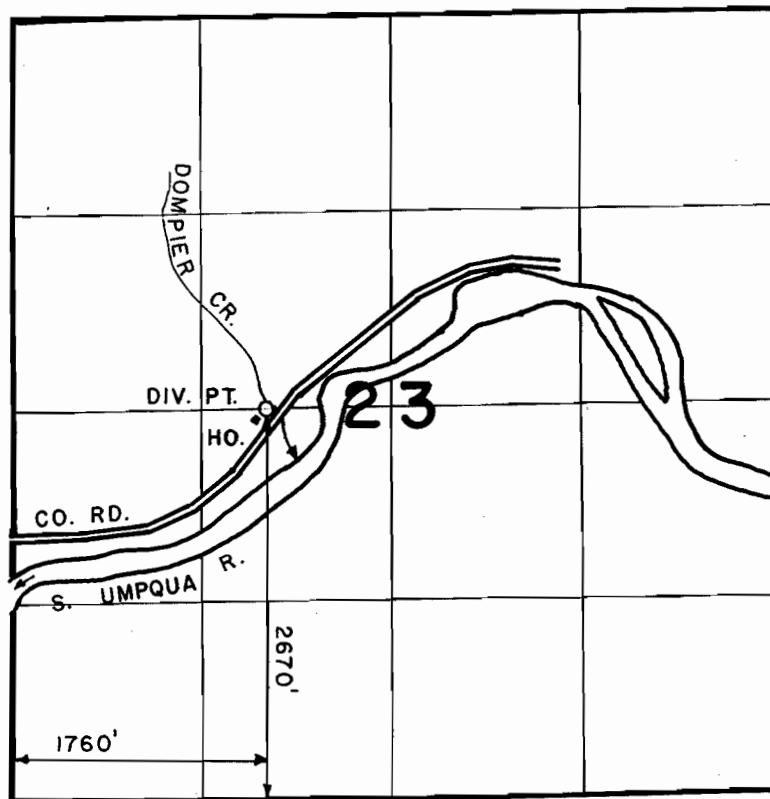

SCALE: 4" = 1 MILE

FINAL PROOF SURVEY UNDER

Application No. 67774 Permit No. 48218.....
IN NAME OF

JOHN C. MILLER AND JOANNE L. MILLER

Surveyed SEPT. 16 1987, by J. KAUPPILA.....