


T. 30 S., R. 6 W., W. M.

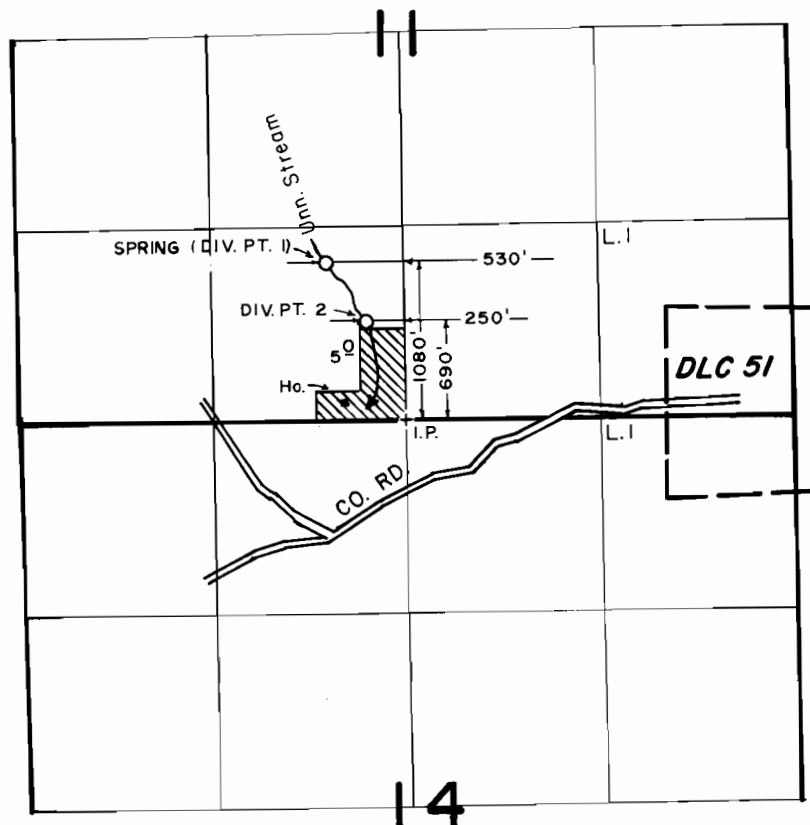

SCALE: 4" = 1 MILE

FINAL PROOF SURVEY UNDER

Application No. 67968 Permit No. 48326
IN NAME OF

LYLE L. LIGHT

Surveyed JULY 15, 1987, by J.M. SCHMORDE
MARCH 6 1990, by B.S. JAMES

Revised: 4-11-90

TAPE & PTS

3/15/89

jk