


T.22S., R.5W., W.M. SECTION 31

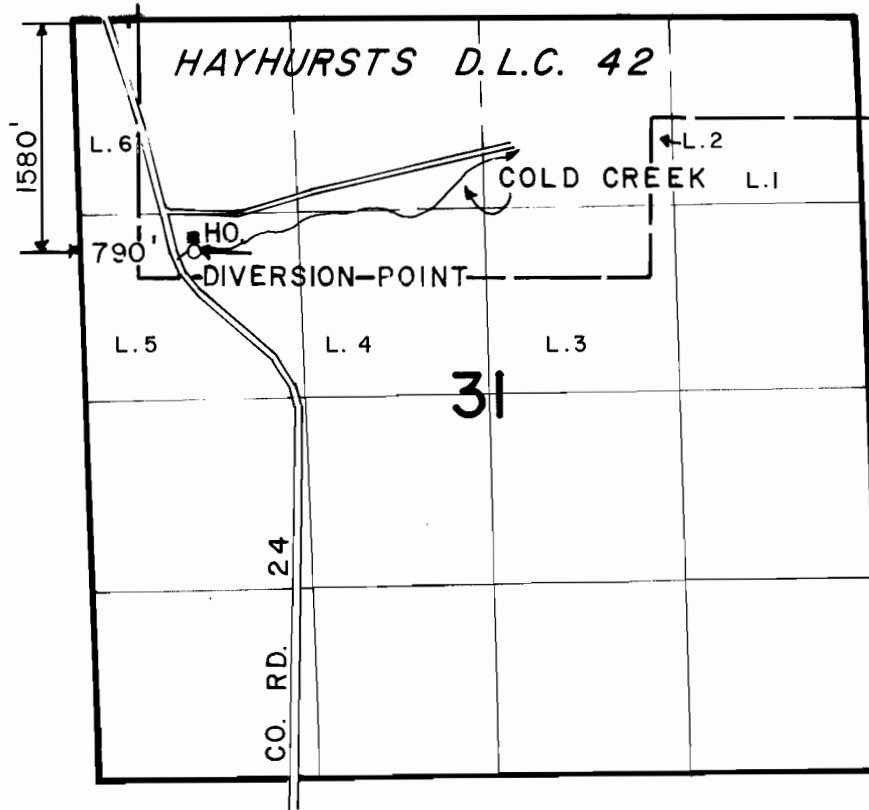

SCALE: 4" = 1 MILE

FINAL PROOF SURVEY UNDER

Application No. 67980 Permit No. 48061
IN NAME OF

THOMAS G. HOLLAMON

Surveyed OCT. 21 1986, by J.M. SCHMORDE