
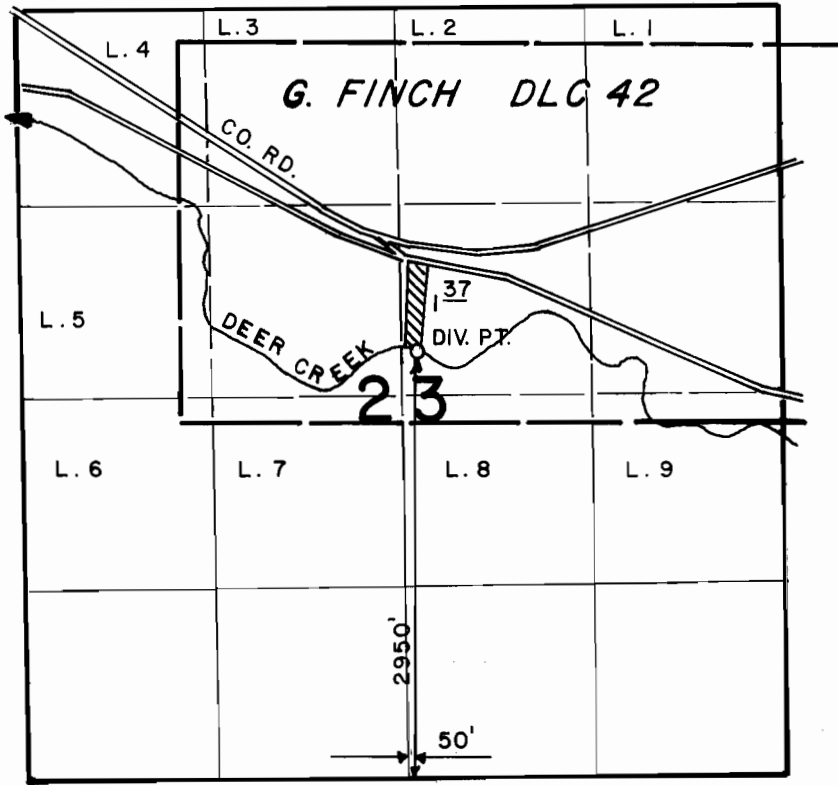


T. 27S., R. 5W., W.M.

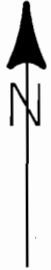

SCALE: 4" = 1 MILE

FINAL PROOF SURVEY
UNDER

Application No. 68331... Permit No. 49357.....
IN NAME OF

PATRICIA ANDERSON

Surveyed OCT. 23, 1987, by J.M. SCHMORDE.