


T. 35S., R. 7 W., W. M.

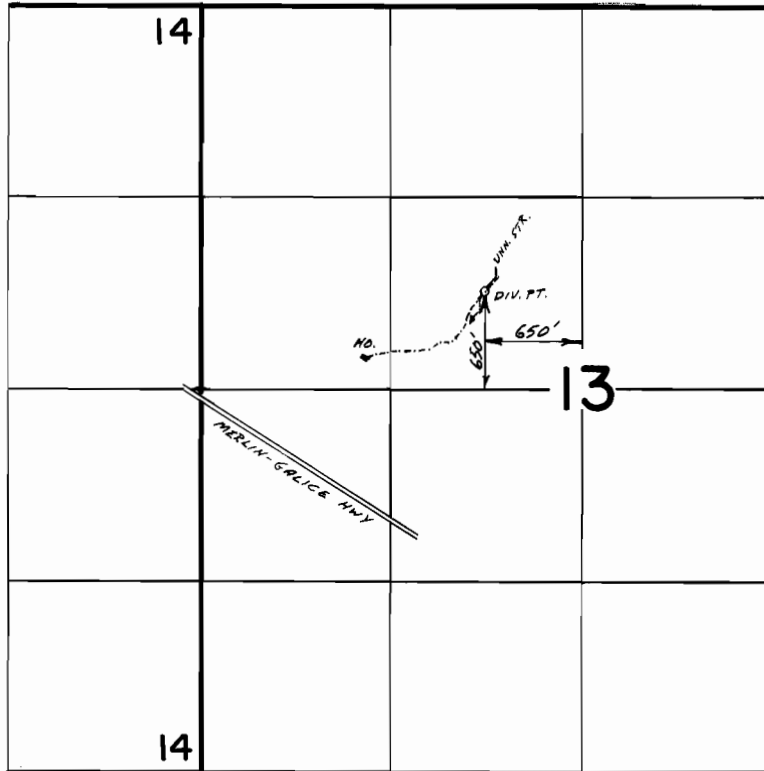

Scale : 1" = 1320'

FINAL PROOF SURVEY UNDER

Application No. **68367**. Permit No. **49431**....
IN NAME OF

HAROLD PAUL BAIMA

Surveyed **Oct. 28, 1987**, by **B.S. JAMES**.....