


T. 27 S., R. 5 W., W. M.

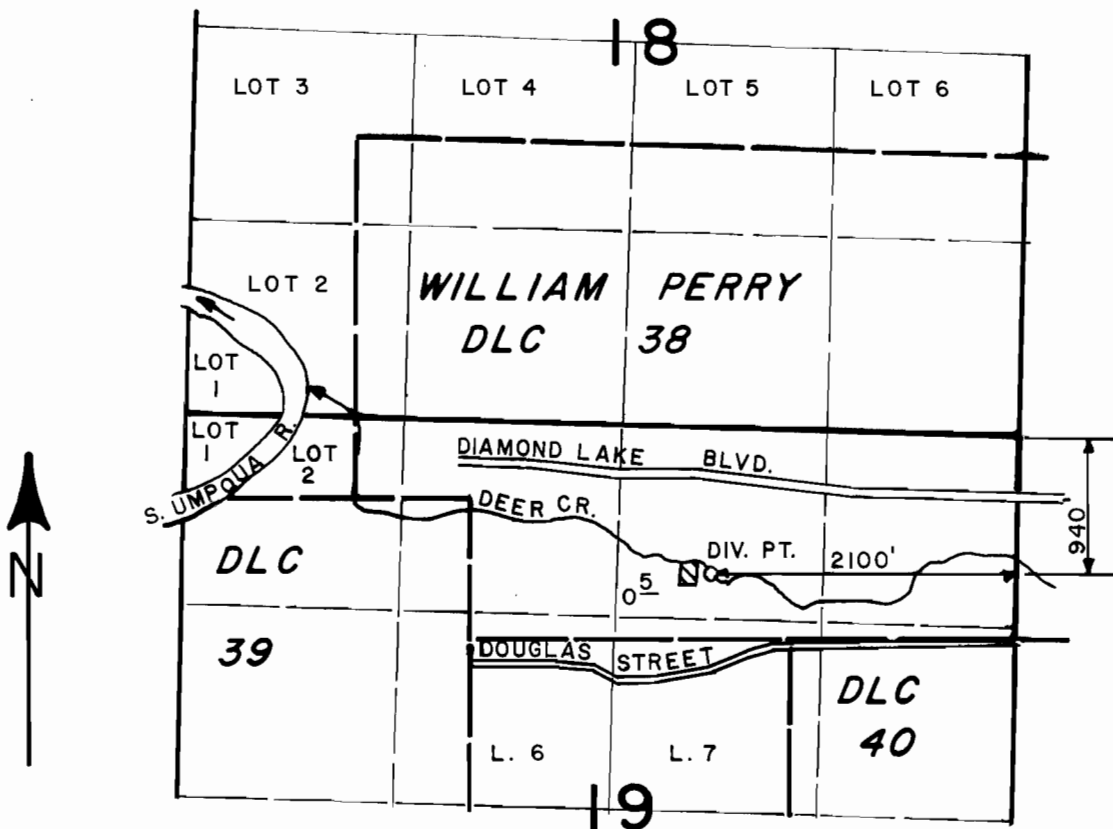

SCALE: 4" = 1 MILE

**FINAL PROOF SURVEY**  
UNDER

Application No. 68392... Permit No. 49393.....  
IN NAME OF

**DELMER L. AND VERA C. CROWLEY**

Surveyed OCT 26... 1987, by J. M. SCHMORDE