


# T. 30S., R. 4 W., W. M. SECTION II

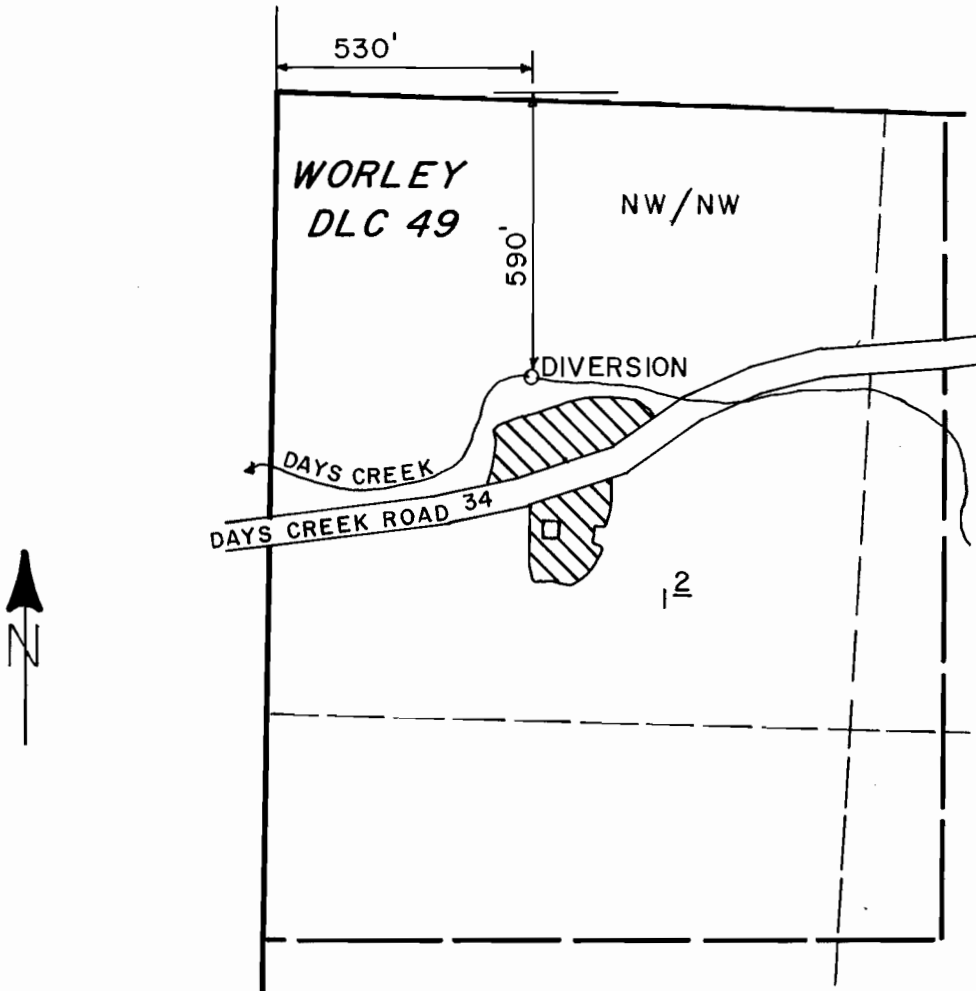

SCALE: 1" = 400'

## FINAL PROOF SURVEY UNDER

Application No. 68412..... Permit No. 49414.....  
IN NAME OF

**TONY B. AND MARIE J. PERIERA**

Surveyed JUNE 4... 1986, by J. M. SCHMORDE