


T. 38 S., R. 5 W., W. M.

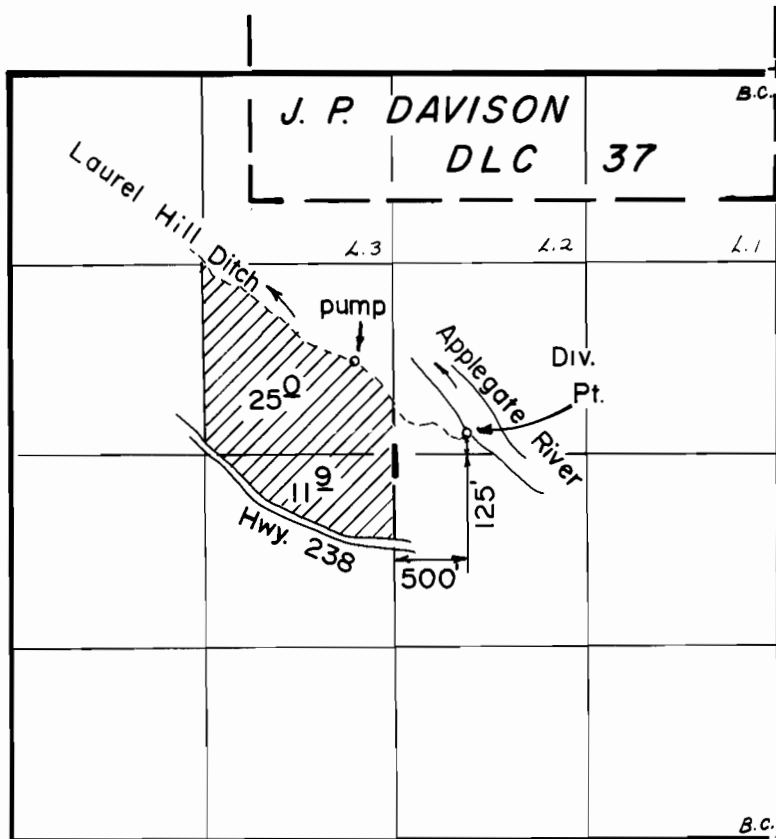

Scale: 1" = 1320'

FINAL PROOF SURVEY
UNDER

Application No. 68416. Permit No. 49638....
IN NAME OF

BUREAU OF LAND MANAGEMENT

Surveyed AUG. 12, 1987., by B. S. JAMES